


CERTIFIED RECORD OF LAND CORNER MONUMENTATION

History of original corner establishment:

Corner established this survey.

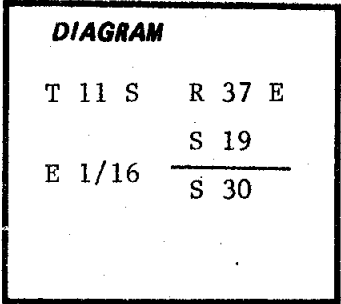

Description of corner evidence found:

Description of monument and accessories established to perpetuate the original location of this corner.

Set a 2½ inch brass cap on a 2 inch iron pipe, 31 inches long, 22 inches in the ground with a 6 foot steel fence post alongside with signs 54-2 and 54-9 attached from which:

New bearing trees:



A pine, 10 ins. diam. bears N. 40° 30' W., 91.2 ft. dist. marked 1/16 S 19 BT  
A pine, 7 ins. diam. bears S. 70° W., 51.0 ft. dist. marked 1/16 S 19 BT

Both BT have a sign 54-3 attached 6 inches below a band of red paint and has a brass washer marked LS 1206 nailed flush with BT blaze.

Brass cap marked thus:

T 11 S    R 37 E  
          S 19  
E 1/16                
          S 30

1978  
ORLS 1206

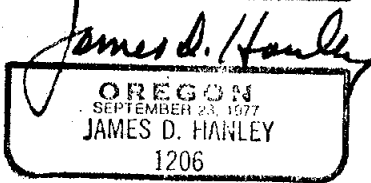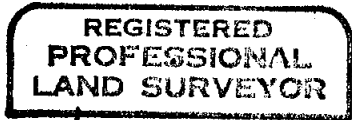

I hereby certify the above corner monument was correctly established on June 15, 1978, witnessed by T. Hanley, R. McKim and T. Fisk.

Office of.....County Surveyor.....County of.....Baker  
State of.....Oregon.....I hereby certify that the within instrument was filed in this office  
for record on the.....day of....., 19.....  
.....by.....  
(COUNTY OFFICER) (DEPUTY)

Form R6-7100-57 (9/71)

☆ GPO - 798-276

FILED 6-30-78  
BAKER COUNTY SURVEYOR  
SURVEY NO. 11-37-25