


CERTIFIED RECORD OF LAND CORNER MONUMENTATION

History of original corner establishment:

Corner established this survey

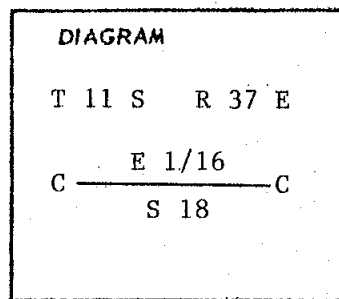

Description of corner evidence found:

Description of monument and accessories established to perpetuate the original location of this corner

Set a 2½ inch brass cap on a 2 inch iron pipe, 31 inches long, 25 inches in the ground with a 6 foot steel fence post alongside with signs 54-2 and 54-9 attached from which:

New bearing trees:

A fir, 6 ins. diam. bears N. 50° W., 27.3 ft. dist. marked 1/16 S 18 BT
A fir, 8 ins. diam. bears S. 57° E., 23.3 ft. dist. marked 1/16 S 18 BT

Each BT has a sign 54-3 attached 6 inches below a band of red paint and has a brass washer marked LS 1206 nailed flush with BT blaze.

Brass cap marked thus:

T 11 S R 37 E

E ~~X~~ 1/16

C ————— C

S 18

1978

ORLS 1206

REGISTERED
PROFESSIONAL
LAND SURVEYOR

James D. Hanley
OREGON
SEPTEMBER 23, 1977
JAMES D. HANLEY
1206

I hereby certify the above corner monument was correctly established on June 19, 1978, witnessed by B. Hanley, R. Spivey and C. Race.

Office of _____ County Surveyor _____ County of _____ Baker _____

State of _____ Oregon _____, I hereby certify that the within instrument was filed in this office

for record on the _____ day of _____

(COUNTY OFFICIAL)

by _____

(DEPUTY)

FILED 6-30-78

BAKER COUNTY SURVEYOR

SURVEY NO. 11-37-26