


CERTIFIED RECORD OF LAND CORNER MONUMENTATION

History of original corner establishment:

Corner established this survey.

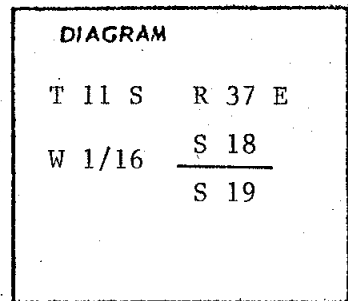

Description of corner evidence found:

Description of monument and accessories I established to perpetuate the original location of this corner

Set a 2½ inch brass cap on a 2 inch iron pipe, 31 inches long, 25 inches in the ground with a 6 foot steel fence post alongside with signs 54-2 and 54-9 attached from which:

New bearing trees:

A pine, 6 ins. diam. bears S. 23° E., 74.1 ft. dist. marked 1/16 S 19 BT
A pine, 8 ins. diam. bears N. 82° E., 37.2 ft. dist. marked 1/16 S 18 BT

Each BT has a sign 54-3 attached 6 inches below a band of red paint and has a brass washer marked LS 1206 nailed flush with BT blaze.

Brass cap marked thus:

T 11 S	R 37 E
W 1/16	<u>S 18</u>
	S 19

1978
ORLS 1206

I hereby certify the above corner monument was correctly established on July 3, 1978 witnessed by B. Hanley and R. Spivey.

REGISTERED
PROFESSIONAL
LAND SURVEYOR

James D. Hanley
OREGON
SEPTEMBER 23, 1977
JAMES D. HANLEY
1206

Office of _____ County Surveyor _____ County of _____ Baker
State of _____ Oregon _____, I hereby certify that the within instrument was filed in this office
for record on the _____ day of _____

(COUNTY OFFICIAL) by _____ (DEPUTY)

FILED 7-31-78
BAKER COUNTY SURVEYOR
SURVEY NO. 11-37-31