


CERTIFIED RECORD OF LAND CORNER MONUMENTATION

History of original corner establishment:

Corner established this survey

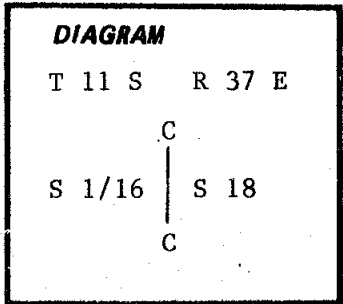

Description of corner evidence found:

Description of monument and accessories I established to perpetuate the original location of this corner:

Set a 2½ inch brass cap on a 2 inch iron pipe, 31 inches long, 26 inches in the ground with a 6 foot steel fence post alongside with signs 54-2 and 54-9 attached from which:


New bearing trees:

A pine, 10 ins. diam. bears N. 62° E., 11.8 ft. dist., marked 1/16 S 18 BT  
 A pine, 8 ins. diam. bears North 22.5 ft. dist. marked 1/16 S 18 BT

Each BT has a sign 54-3 attached 6 inches below a band of red paint and has a brass washer marked LS 1206 nailed flush with BT blaze.


Brass cap marked thus:

T 11 S    R 37 E

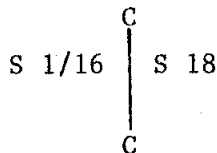

1978

ORLS 1206

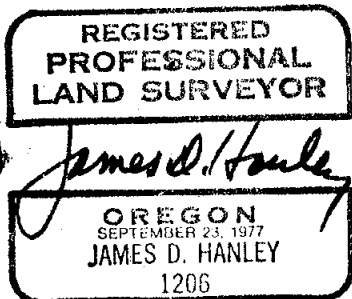

I hereby certify the above corner monument was correctly established on July 3, 1978 witnessed by B. Hanley and R. Spivey.

Office of..... County Surveyor                      County of..... Baker  
 State of..... Oregon                      I hereby certify that the within instrument was filed in this office  
 for record on the..... day of....., 19.....  
 ..... by .....  
 (COUNTY OFFICIAL)                      (DEPUTY)

Form R6-7100-57 (9/71)

☆ GPO : 798-276

FILED 7-31-78  
 BAKER COUNTY SURVEYOR  
 SURVEY NO. 11-37-33