


CERTIFIED RECORD OF LAND CORNER MONUMENTATION

History of original corner establishment:

Corner established this survey:

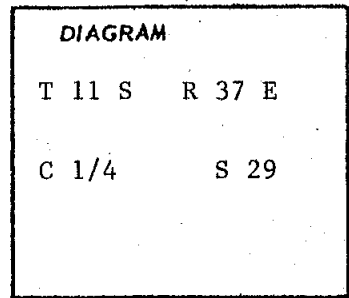

Description of corner evidence found:

Description of monument and accessories established to perpetuate the original location of this corner

Set a 2½ inch brass cap on a 2 inch iron pipe, 31 inches long, 27 inches in the ground with a 6 foot steel fence post alongside with a sign 54-9 attached from which:

New bearing trees:

A juniper, 12 ins. diam. bears N. 88° W., 30.2 ft. dist. marked C 1/4 S 29 BT
A juniper, 8 ins. diam. bears N. 03° E., 35.4 ft. dist. marked C 1/4 S 29 BT



Each BT has a sign 54-3 attached 6 inches below a band of red paint and has a brass washer marked LS 1206 nailed flush with BT blaze.

Brass cap marked thus:

T 11 S R 37 E

C 1/4 S 29

1978
ORLS 1206

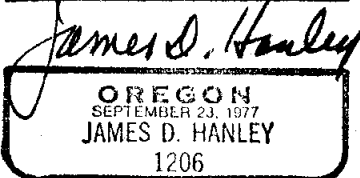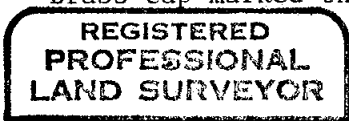

I hereby certify the above corner monument was correctly established on July 7, 1978, witnessed by B. Hanley, R. Spivey and R. McKim.

Office of _____ County Surveyor _____ County of _____ Baker
State of _____ Oregon _____, I hereby certify that the within instrument was filed in this office
for record on the _____ day of _____

(COUNTY OFFICIAL) by _____
(DEPUTY)

FILED 7-31-78
BAKER COUNTY SURVEYOR
BOOK NO. 11-37-36