

CERTIFIED RECORD OF LAND CORNER MONUMENTATION

History of original corner establishment:

Corner established in 1881 by Herman D. Gradon, Under General Land Office Contract No. 416. Surveyor General Notes State: Set a sandstone 16x8x5 ins., 11" in the ground for $\frac{1}{4}$ section corner, marked $\frac{1}{4}$ on N face. From which:
A Juniper 10" dia. bears N65°E, 45 lks dist., marked $\frac{1}{4}$ S BT.
A " 12" dia. bears S85°W, 28 lks dist., marked $\frac{1}{4}$ S BT.

CONTINUED ON ATTACHED SHEET.

DIAGRAM

T11S R37E
 $\frac{1}{4}$ S15
S22
1974
B.L.M.

Description of corner evidence found:



Found brass cap monument as established by the B.L.M., stamped as shown on the diagram.
In good condition.
Found original tree and tree established by the B.L.M. as described on history.

Description of monument and accessories I established to perpetuate the original location of this corner:

Maintained corner by setting steel post with warning sign alongside.
Re-scribed original Juniper bearing tree $\frac{1}{4}$ S22 BT, bears S89°W, 18.6 ft. record (S85°W) (18.4 ft).
Nailed brass washer stamped PLS848, bearing tree sign to trees and painted 6" red band around the tree. Painted 6" red band around the trees as established by the B.L.M., bears N21°W, record (n24°W).

Corner monumented 9-6-83

Witnessed by Dan Martin

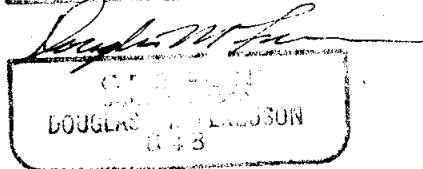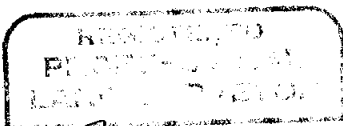

FILED Nov 17, 1983
BAKER COUNTY SURVEYOR
SURVEY NO. 11-37-40

Office of..... County of.....
State of....., I hereby certify that the within instrument was filed in this office
for record on the..... day of....., 19.....

..... by
(COUNTY OFFICIAL) (DEPUTY)