

CERTIFIED RECORD OF LAND CORNER MONUMENTATION

History of original corner establishment:

Corner established in 1881, by Herman D. Gradon, Under General Land Office Contract No. 416. Surveyor Generals Notes State: Set a basalt stone 16x10x5" 11" in the ground for corner to secs. 10,11,14, and 15, marked with 4 notches on S and 2 notches on E edges. From which:
A Pine 30" dia. bears N50°E, 78 lks dist., marked T11S R37E S11 BT.
A Juniper 12" dia. bears S53°E, 70 lks dist., marked T11S R37E S14 BT.
A Pine 14" dia. bears S35°W, 116 lks dist., marked T11S R37E S15 BT.
A Pine 40" dia. bears N20°W, 28 lks dist., marked T11S R37E S10 BT.

DIAGRAM

T11S	R37E
S10	S11
S15	S14
1974	
PLS848	

CONTINUED ON ATTACHED SHEET.


Description of corner evidence found:

Found a brass cap monument stamped as shown in diagram, in good condition.
Found original bearing trees and evidence as described by B.L.M.
Found bearing trees as scribed by the B.L.M.

Description of monument and accessories | established to perpetuate the original location of this corner:

Maintained corner by setting a steel post alongside pipe and raising a mound of stone around pipe.
Maintained bearing trees by nailing bearing tree and warning signs as needed, painted 6" red band around each tree.

Corner monumented 9-7-83
Witnessed by Dan Martin

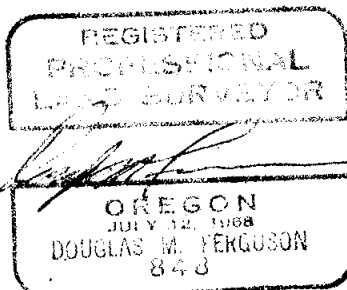

Office of..... County of.....
State of....., I hereby certify that the within instrument was filed in this office
for record on the..... day of....., 19.....
..... by
(COUNTY OFFICIAL) (DEPUTY)

Form R6-7100-57 (9/71)

FILED Nov. 17, 1983
BAKER COUNTY SURVEYOR
SURVEY NO. 11-37-42

OPC-798-276