

CERTIFIED RECORD OF LAND CORNER MONUMENTATION

History of original corner establishment:

Corner established in 1881 by Herman D. Gradon, Under General Land Office Contract No. 416. Surveyor Generals Notes state: Set a basalt stone 16x7x7," 11" in the ground for $\frac{1}{4}$ section cor. marked $\frac{1}{4}$ on W face, From which:
A Mahogany 8" dia. bears N50⁰E, 114 lks dist., marked $\frac{1}{4}$ S BT.
A " 5" dia. bears N45⁰W, 76 lks dist., marked $\frac{1}{4}$ S BT.

DIAGRAM

T11S R37E
 $\frac{1}{4}$
S16 | S15
1974
B.L.M.

CONTINUED ON ATTACHED SHEET.

Description of corner evidence found:



Found brass cap monument stamped as shown on the diagram, as set by the B.L.M., in good condition.
Found original bearing trees and trees taken by the B.L.M. as called for in the original notes and in the re-monumentation notes by the B.L.M.

Description of monument and accessories | established to perpetuate the original location of this corner:

Maintained corner by setting steel posts with warning and boundry signs South 5 ft. and East 5 ft. from corner.
Nailed bearing trees and warning signs to bearing trees as needed and painted 6" red band around each tree.

Corner monumented 9-7-83

Witnessed by Dan Martin

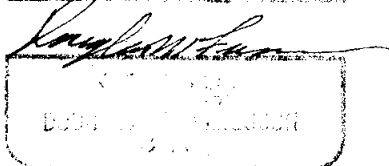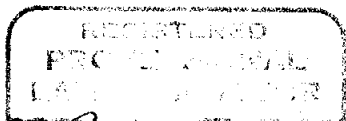

Office of..... County of.....
State of....., I hereby certify that the within instrument was filed in this office
for record on the..... day of....., 19.....

(COUNTY OFFICIAL)

(DEPUTY)

Form R6-7100-57 (9/71)

FILED Nov. 17, 1933
BAKER COUNTY SURVEYOR
SURVEY NO. 11-37-44