

CERTIFIED RECORD OF LAND CORNER MONUMENTATION

**History of original corner establishment:**

Corner established in 1881 by Herman D. Gradon, Under General Land Office Contract No. 416. Surveyor Generals Notes state: Set sandstone 14x10x8" 9" in the ground for corner to sections 9, 10, 15, and 16, marked with 4 notches on S and 3 notches on E edges. From Which.  
A Pine 10" dia. bears N30°E, 25 lks dist. marked T11S R37E S10 BT.  
A Fir 12" dia. bears S55°E, 47 lks dist. marked T11S R37E S15 BT.  
A " 24" dia. bears S10°W, 47 lks dist. marked T11S R37E S16 BT.  
A Tamarack 24" dia. bears N35°W, 41 lks dist. marked T11S R37E S9 BT.

**DIAGRAM**



|        |      |
|--------|------|
| T11S   | R37E |
| S9     | S10  |
| S16    | S15  |
| 1974   |      |
| B.L.M. |      |

**Description of corner evidence found:**

Found brass cap monument stamped as shown on the diagram.  
As set by the B.L.M., in good condition.  
Found original bearing trees as follows:  
A Pine 15" dia. bears N30°E, 16.5 ft. blaze healed over.  
A Tamarack 23" dia. bears N35°W, 27 ft. with scribing reads S9 BT.  
Found bearing trees established by B.L.M. as follows:  
A Pine 11" dia. bears S60°E, 21.1 ft. scribing visible.  
A " 14" dia. bears S41°W, 11.6 ft scribing visible

**Description of monument and accessories | established to perpetuate the original location of this corner:**

Maintained corner by setting a steel post with warning sign South 2 ft. from corner.  
Nailed a bearing tree sign to original NE bearing tree.  
Painted 6" red band around each tree.

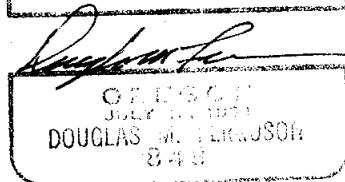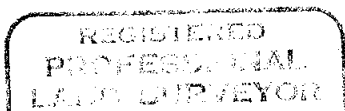

Corner monumented 9-7-83  
Witnessed by Dan Martin

Office of..... County of.....  
State of....., I hereby certify that the within instrument was filed in this office  
for record on the..... day of....., 19.....  
..... by .....  
(COUNTY OFFICIAL) (DEPUTY)