

CERTIFIED RECORD OF LAND CORNER MONUMENTATION

History of original corner establishment:

Corner established in 1881, by Herman D. Gradon, Under General Land Office Contract No. 416. Surveyor Generals notes state: Set sandstone 14x8x6", 9" in the ground for $\frac{1}{4}$ section corner, marked $\frac{1}{4}$ on N face.
From which:
A Tamarack 24" dia. bears N50°W, 24 lks dist. marked $\frac{1}{4}$ S BT.
A Pine 22" dia. bears S30°E, 68 lks dist., marked $\frac{1}{4}$ S BT.

DIAGRAM



T11S R37E
S10
 $\frac{1}{4}$ S15
1983
PLS848

Description of corner evidence found:

Corner falls on roadbed of the old Sumpter Valley Rail-road, no evidence of original stone found.
Found rotten Pine stump with blaze face standing against the rotten interior, scribed $\frac{1}{4}$ S BT. The other tree fell in the road way of the Sumpter Valley rail- road, set corner at record N30°W, 44.9 ft. from chaining notch in the blaze of the rotten stump.

Description of monument and accessories | established to perpetuate the original location of this corner:

Set a 30"x2 $\frac{1}{2}$ " aluminum pipe with a 2 $\frac{1}{2}$ " aluminum cap stamped as shown in the diagram. Set 15" in the ground and raised a mound of stone around the pipe.
From which:
A Fir 12" dia. bears N48°E, 1.7 ft. scribed $\frac{1}{4}$ S10 BT.
A " 8" dia. bears S22°E, 29.6 ft. scribed $\frac{1}{4}$ S15 BT.
Set steel post with warning sign 4.0 ft. South.
Nailed brass washers stamped PLS848, bearing tree and warning signs to each tree.
Painted 6" red band around each tree.

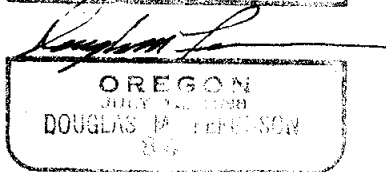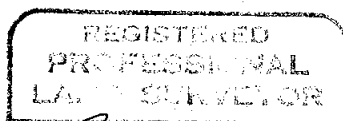

Corner monumented 8-17-83

Witnessed by D. Mitchell Ferguson

Office of..... County of.....
State of....., I hereby certify that the within instrument was filed in this office
for record on the..... day of....., 19.....
..... by
(COUNTY OFFICIAL) (DEPUTY)