


CERTIFIED RECORD OF LAND CORNER MONUMENTATION


History of original corner establishment:
Corner not previously established.

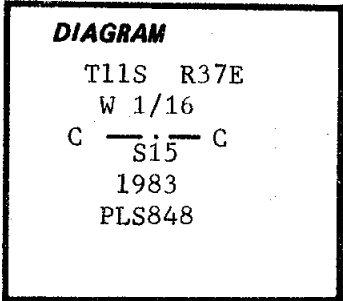

Description of corner evidence found:
N/A

Description of monument and accessories I established to perpetuate the original location of this corner:
Set a 30"x2½" aluminum pipe with a 2½" aluminum cap stamped as shown in diagram.
Set 24" in the ground.
From which:
A Pine 6" dia. bears S45°E, 24.7 ft. scribed C-W 1/16 S15 BT.
A " 7" dia. bears N3°E, 15.0 ft. scribed C-W 1/16 S15 BT.
Set steel posts with warning and boundry signs South 3.0 ft. and West 4.0 ft.
Nailed brass washers stamped PLS848, bearing tree and warning signs to each tree.
Painted 6" red band around each tree.

Corner monumented 9-6-83
Witnessed by Dan Martin

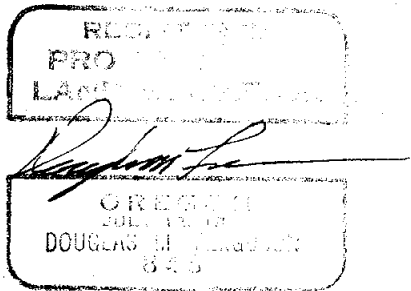

Office of..... County of.....
State of....., I hereby certify that the within instrument was filed in this office
for record on the..... day of....., 19.....
..... by
(COUNTY OFFICIAL) (DEPUTY)