

CERTIFIED RECORD OF LAND CORNER MONUMENTATION

History of original corner establishment:

Corner not previously established.

DIAGRAM

T11S R37E
W1/16
C — S30 — C
1983
PLS848

Description of corner evidence found:

N/A

Description of monument and accessories I established to perpetuate the original location of this corner:

Set a 30"x2½" aluminum pipe with a 2½" aluminum cap stamped as shown in the diagram.
Set 26" in the ground.

From which:



A Pine 7" dia. bears N53°W, 15.8 ft. scribed C-W 1/16 S30 BT.

A " 8" dia. bears S46°W, 26.7 ft. " C-W 1/16 S30 BT.

Set steel posts with warning an boundry signs N & E 5 ft.

Nailed brass washers stamped PLS848, bearing tree and warning signs to each tree.

Painted 6" red band around each tree.

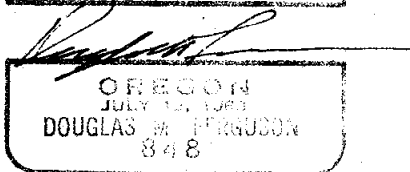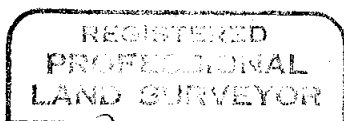

Corner monumented 9-5-83

Witnessed by Dan Martin

Office of..... County of.....
State of....., I hereby certify that the within instrument was filed in this office
for record on the..... day of....., 19.....

..... by
(COUNTY OFFICIAL) (DEPUTY)

Form R6-7100-57 (9/71)

Nov. 17, 1983
BAKER COUNTY SURVEYOR
SURVEY NO. 11-37-58

☆ GPO—798-276