

CERTIFIED RECORD OF LAND CORNER MONUMENTATION

History of original corner establishment:

Corner not previously established.

DIAGRAM

T11S R37E
SE 1/16
S30
1983
PLS848


Description of corner evidence found:

N/A

Description of monument and accessories I established to perpetuate the original location of this corner:

Set a 30"x2½" aluminum pipe with a 2½" aluminum cap stamped as shown in diagram.
Set 4" in the ground and raised a mound of stone 28" high by 36" dia.
from which:
A Pine 12" dia. bears S40°W, 4.3 ft. scribed SE 1/16 S30 BT.
A Juniper 12" dia. bears S65°E, 23.2 ft. scribed SE 1/16 S30 BT.
Set steel posts with warning and boundry signs North 8 ft. from corner.
Nailed brass washers stamped PLS848, bearing tree and warning signs to each tree.
Painted 6" red band around each tree.

REGISTERED
PROFESSIONAL
LAND SURVEYOR

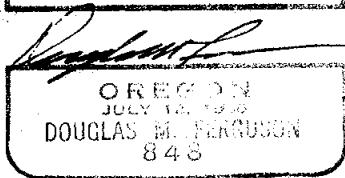

Corner monumented 9-5-83

Witnessed by Dan Martin

Office of..... County of.....
State of....., I hereby certify that the within instrument was filed in this office
for record on the..... day of....., 19.....

..... by
(COUNTY OFFICIAL)

(DEPUTY)

Form R6-7100-57 (9/71)

FILED Nov. 17, 1983
BAKER COUNTY SURVEYOR
SURVEY NO. 11-37-59