

CERTIFIED RECORD OF LAND CORNER MONUMENTATION

History of original corner establishment:

Corner not previously established.

DIAGRAM

T11S R37E
C-N-S
1/64 S30
1983
PLS848

Description of corner evidence found:

N/A

Description of monument and accessories | established to perpetuate the
original location of this corner:

Set a 30" x 2½" aluminum pipe with a 2½" aluminum cap stamped as shown in diagram.
Set 26" in the ground.

From which:


A Pine 9" dia. bears N33°W, 8.1 ft. scribed CNS 1/64 S30 BT.

A Pine 6" dia. bears S70°E, 4.0 ft. scribed CNS 1/64 S30 BT.

Set steel posts with warning and boundry signs East 6.1 ft. and West 5.0 ft.


Nailed brass washers stamped PLS848, bearing tree and warning signs to each tree.

Painted 6" red band around each tree.

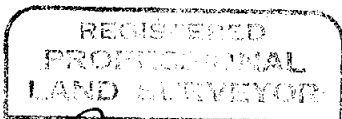

Corner monumented 9-5-83

Witnessed by Dan Martin

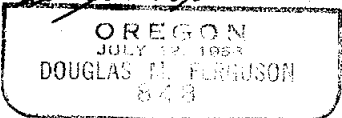

Office of..... County of.....

State of....., I hereby certify that the within instrument was filed in this office
for record on the..... day of....., 19.....

..... by
(COUNTY OFFICIAL) (DEPUTY)

Form R6-7100-57 (9/71)

FILED Nov. 17, 1983
BAKER COUNTY SURVEYOR
SURVEY NO. 11-37-61

☆ GPO—798-278