


CERTIFIED RECORD OF LAND CORNER MONUMENTATION

Y-251

History of original corner establishment:

None. Corner established with this survey.

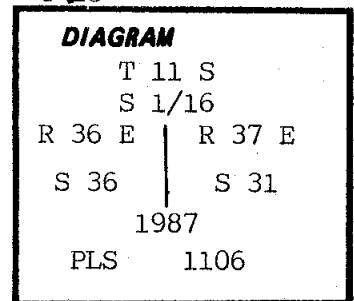

Description of corner evidence found:

None.

Description of monument and accessories | established to perpetuate the original location of this corner:

At position established by survey...

Set 2½" x 30" aluminum pipe with 2½" aluminum cap 8" in ground to bedrock and surrounded with a mound of earth and stone. Cap marked as shown in corner diagram.

New bearing trees established:


A 6" ponderosa pine brs N5½°E, 31.0' dist mkd S1/16S31 BT.

A 7" juniper brs N36½°W, 21.1' dist mkd S1/16S36 BT.


New bearing trees have a brass washer stamped PLS 1106 nailed to face of blaze. Attached signs 54-3 & 54-9 and painted face of blaze and a 6" band of red around each BT. Set steel fence post North of corner and attached sign 54-9 and 54-2.

Compass declination 19° East.

I hereby certify that the above corner monument was properly established to U.S.F.S. standards under my supervision November 2, 1987.

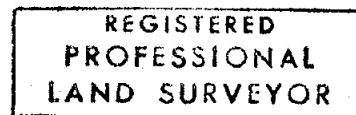

William R. Wells

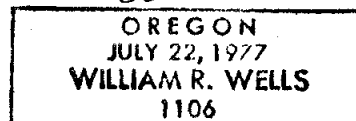

Office of..... County Surveyor..... County of..... Baker
State of..... Oregon....., I hereby certify that the within instrument was filed in this office
for record on the..... day of....., 19.....

..... by
(COUNTY OFFICIAL) (DEPUTY)