


CERTIFIED RECORD OF LAND CORNER MONUMENTATION

History of original corner establishment:

None. Corner established with this survey.

Z X-2

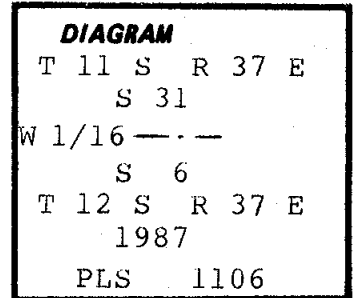

Description of corner evidence found:

None.

Description of monument and accessories I established to perpetuate the original location of this corner:

At position established by survey...

Set 2½" x 30" aluminum pipe with 2½" aluminum cap 14" in ground to bedrock and surrounded with a mound of earth and stone. Cap marked as shown in corner diagram.

New bearing trees established:


A 8" ponderosa pine brs N49½°E, 23.5' scribed W1/16S31 BT.

A 9" ponderosa pine brs S29½°E, 30.2' scribed W1/16S6 BT.


New bearing trees have a brass washer stamped PLS 1106 nailed to face of blaze. Attached signs 54-3 & 54-9 and painted face of blaze and a 6" band of red around each BT. Set steel fence post West of corner and attached sign 54-9.

Compass declination 19° East.

I hereby certify that the above corner monument was properly established to U.S.F.S. standards under my supervision on November 2, 1987.

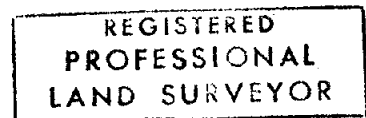

*William R. Wells*

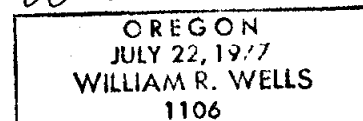

Office of.....County Surveyor..... County of.....Baker.....  
State of.....Oregon....., I hereby certify that the within instrument was filed in this office  
for record on the..... day of....., 19.....

..... by .....  
(COUNTY OFFICIAL) (DEPUTY)