


CERTIFIED RECORD OF LAND CORNER MONUMENTATION

Z X-4

History of original corner establishment:

None. Corner established with this survey.

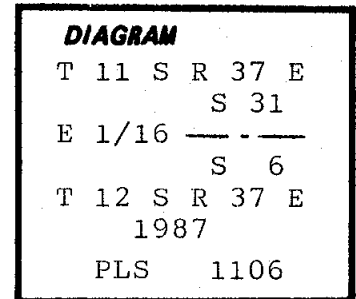

Description of corner evidence found:

None.

Description of monument and accessories I established to perpetuate the original location of this corner:

At position established by survey...

Set 2½" x 30" aluminum pipe with 2½" aluminum cap 24" in ground to bedrock and surrounded with a mound of earth only. Cap marked as shown in corner diagram.

New bearing trees established:


A 8" ponderosa pine brs N30½°W, 25.8' scribed E1/16S31 BT.

A 25" ponderosa pine brs S65½°E, 67.2' scribed E1/16S6 BT.


New bearing trees have a brass washer stamped PLS 1106 nailed to face of blaze. Attached signs 54-3 & 54-9 and painted face of blaze and a 6" band of red around each BT. Set steel fence post East and South of corner and attached sign 54-9 to one post and 54-2 to both posts.

Compass declination 19° East.

I hereby certify that the above corner monument was properly established to U.S.F.S. standards by me on November 2, 1987.

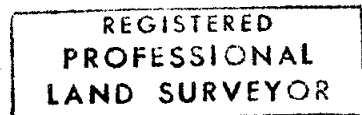

William R. Wells

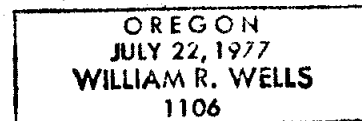

Office of..... County Surveyor..... County of..... Baker.....
 State of..... Oregon....., I hereby certify that the within instrument was filed in this office
 for record on the..... day of....., 19.....

..... by
 (COUNTY OFFICIAL) (DEPUTY)