

CERTIFIED RECORD OF LAND CORNER MONUMENTATION

2 X-5


History of original corner establishment:

Corner originally established by Eugene P. McCornack under Contract No. 398 and dated July 02, 1881.

Surveyor General records state:

Set post 4' long 4" square 24" in ground for corner to Secs 5, 6, 31 & 32 marked T11SS32 on NE, R37ES5 on SE, T12SS6 on SW and S31 on NW face with 5 notches on E and 1 notch on W edge from which:

- A pine 36" dia brs N40°E, 51 lks dist mkd T11SR37ES32 BT.
- A pine 36" dia brs S60°E, 75 lks dist mkd T12SR37ES5 BT.
- A pine 3" dia brs S75°W, 67 lks dist mkd T12SR37ES6 BT.
- A pine 24" dia brs N30°W, 132 lks dist mkd T11SR37ES31 BT.

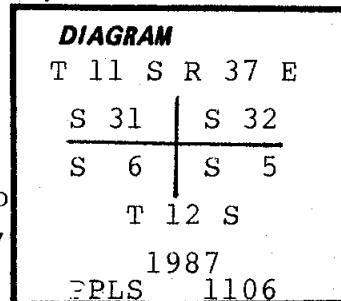

Description of corner evidence found:

None. Corner search of 6 hours on 3 different occasions with 2 man crew including 1 PLS. There is a location poster on tree 100' south indicating approx corner is 3 chains North. The area has been logged & burnt & is now a pasture.

Description of monument and accessories | established to perpetuate the original location of this corner:

Re-established corner by single proportionate measure between found 1/4 S 31 and found S 32 | S 33...

Set 2 1/2" aluminum pipe with 2 1/2" aluminum cap 22" in the ground and surrounded with a mound of earth and stone. Cap marked as shown in corner diagram.

New bearing trees established:

- A 21" ponderosa pine brs N06°E, 159.4' dist mkd T11SR37ES32 BT.
- A 11" ponderosa pine brs S03°E, 119.4' dist mkd T12SR37ES5 BT.
- A 13" ponderosa pine brs S20 1/2°W, 99.7' dist mkd T12SR37ES6 BT.
- A 20" ponderosa pine brs N9 1/2°W, 109.6' dist mkd T11SR37ES31 BT.

New bearing trees have a brass washer stamped PLS 1106 nailed to face of blaze. Attached signs 54-3 & 54-9, painted face of blaze and 6" band of red around each BT. Set steel fence post West of corner and attached sign 54-9 & 54-2.

Compass declination 19° East.

I hereby certify that the above corner monument was properly re-established to U.S.F.S. standards by me on November 02, 1987.

REGISTERED
PROFESSIONAL
LAND SURVEYOR

William R. Wells

OREGON
JULY 22, 1977
WILLIAM R. WELLS
1106

Office of.....County Surveyor.....County of.....Baker.....
State of.....Oregon....., I hereby certify that the within instrument was filed in this office
for record on the.....day of....., 19.....

.....by.....
(COUNTY OFFICIAL) (DEPUTY)