



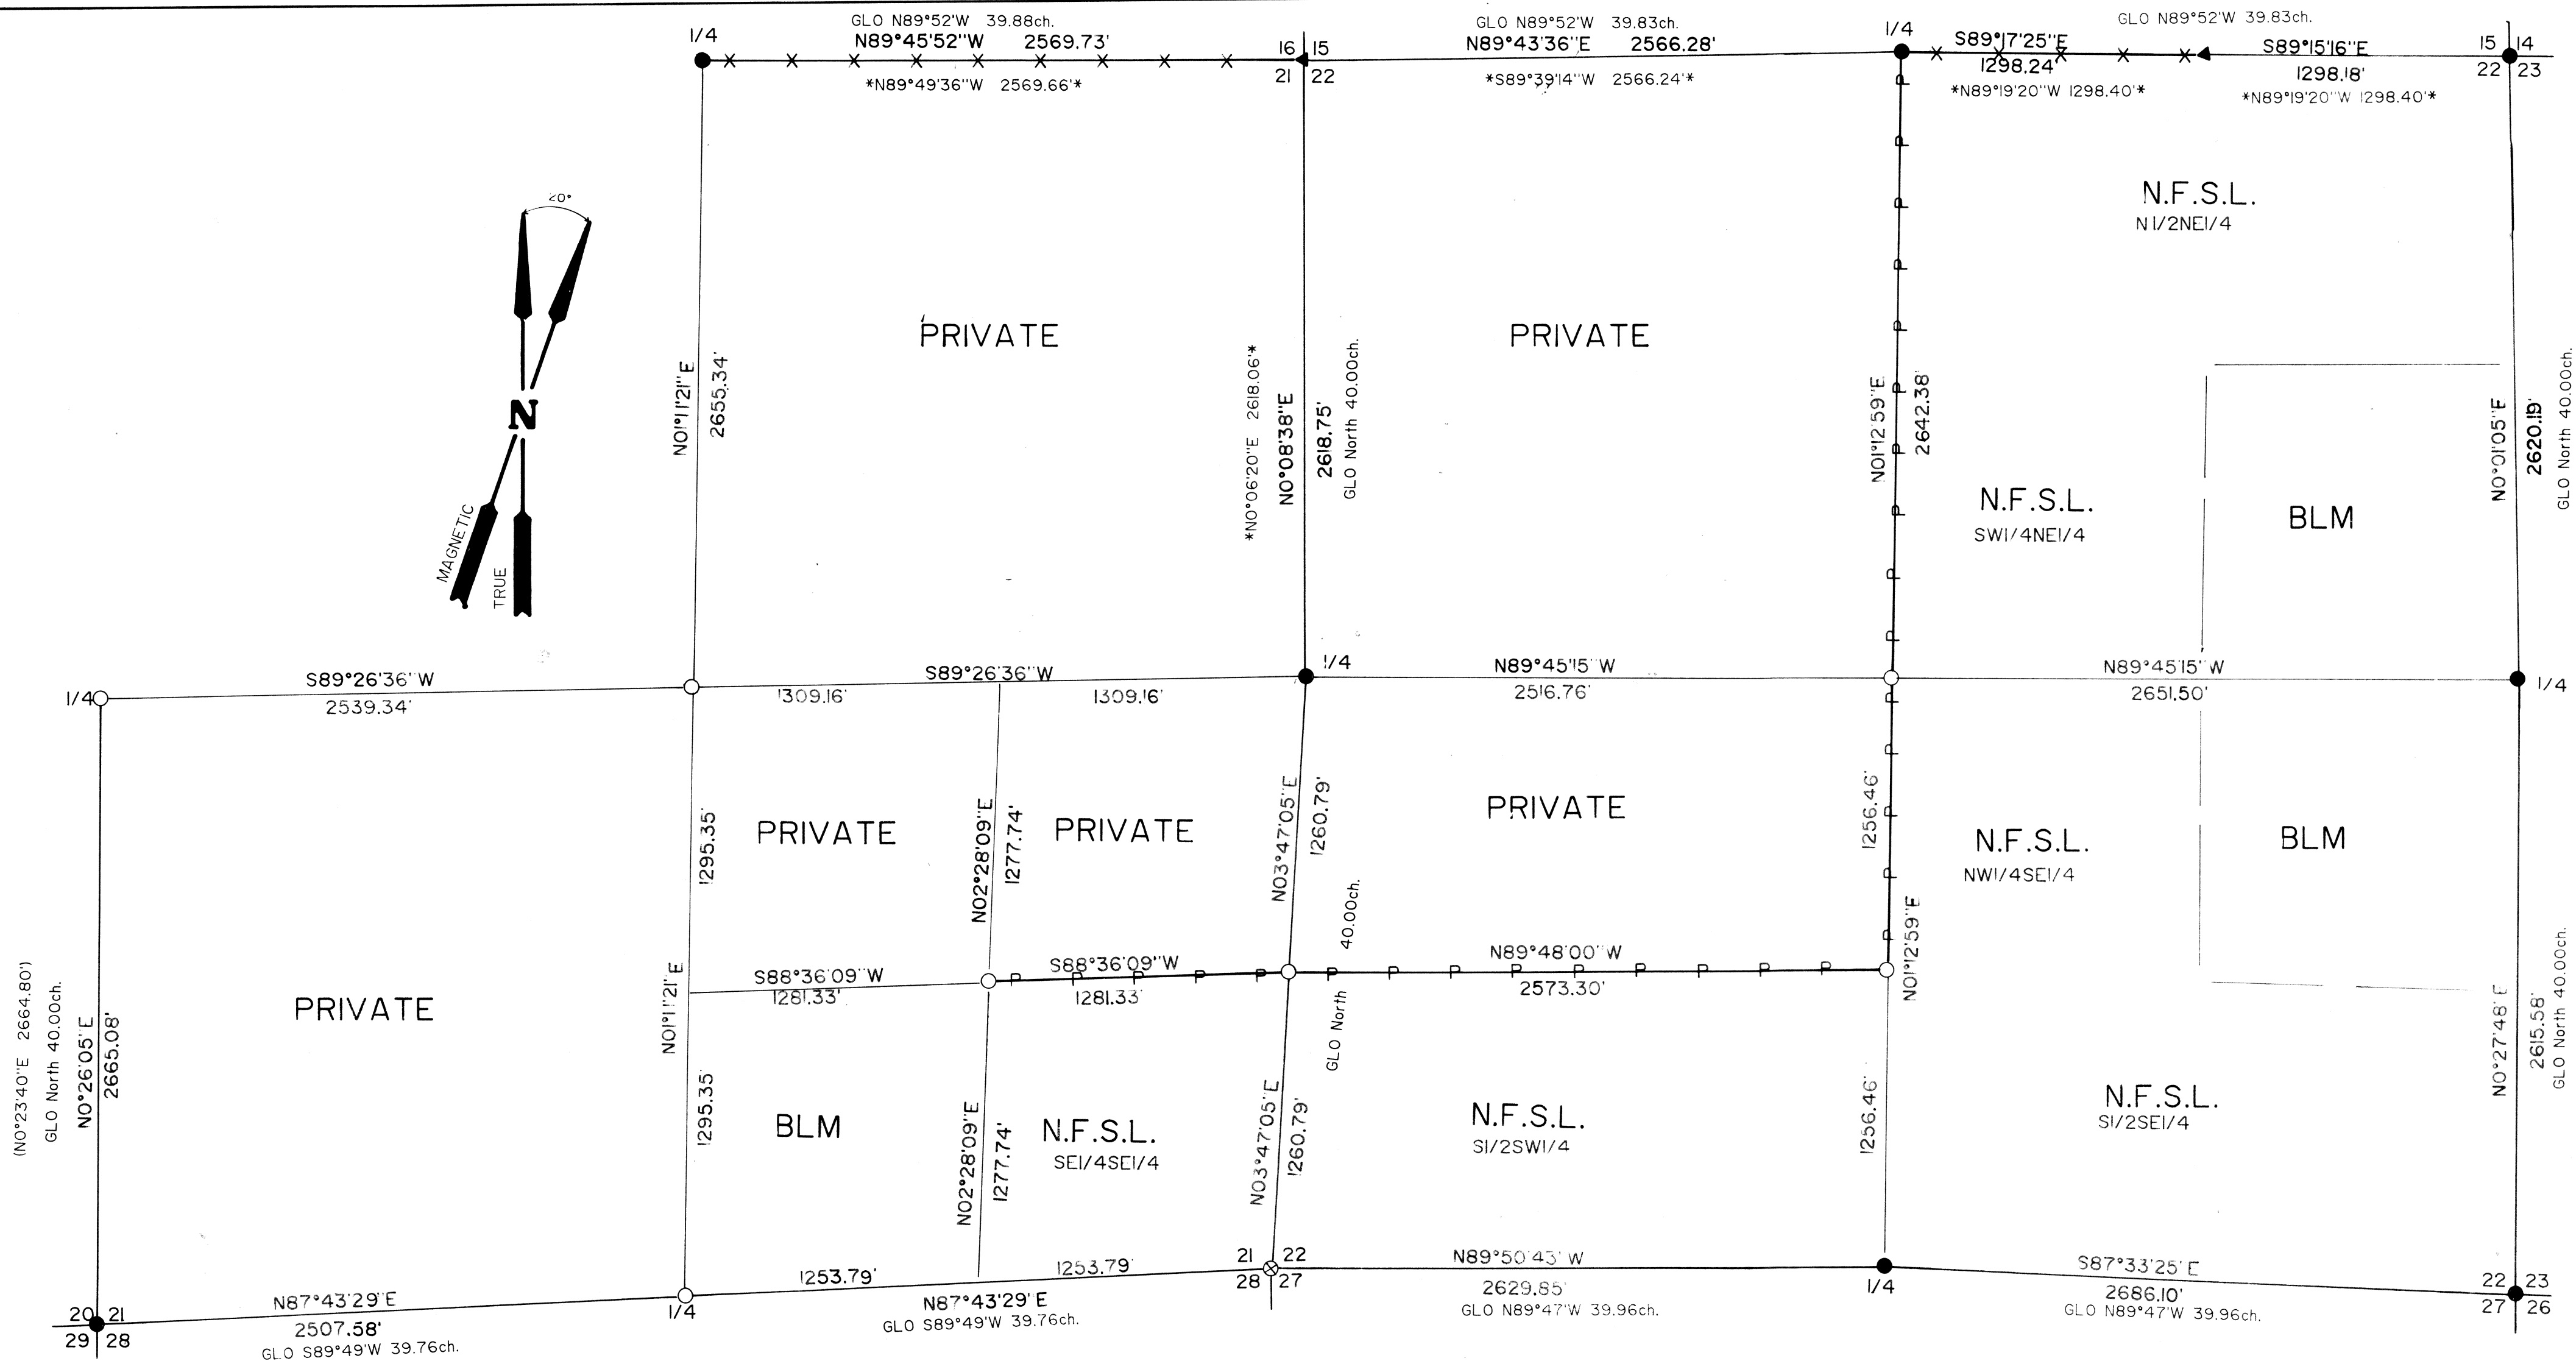

HISTORY OF SURVEYS

The East and South lines of this township were originally surveyed by Deputy Eugene P. McCormack in 1881 under Contract No. 398. The subdivision lines of this township were originally surveyed by Deputy Herman D. Gradon in 1881 under Contract No. 416. In 1974 Cadastral Surveyors Lester E. Fischer and Owen C. Chatters, II monumented the original corners from original evidence under Group No. 350. In 1978 PLS James D. Hanley and PLS William L. Hanley retraced the West lines of Sections 21 & 28, CS file No. 11-37-39. In 1983 PLS Douglas M. Ferguson retraced the North lines of Sections 21 & 22 and the North one-half of the line between Sections 21 & 22, CS file No. 11-37-62.


EXAMINED AND ACCEPTED FOR THE U.S. FOREST SERVICE
this 21ST day of JANUARY, 1998
Royce Han COR
I CERTIFY THAT THIS SURVEY WAS PERFORMED AT THE REQUEST
OF THE WALLOWA-WHITMAN NATIONAL FOREST SUPERVISOR
Karyn A. Wood 1-21-98
SIGNATURE DATE

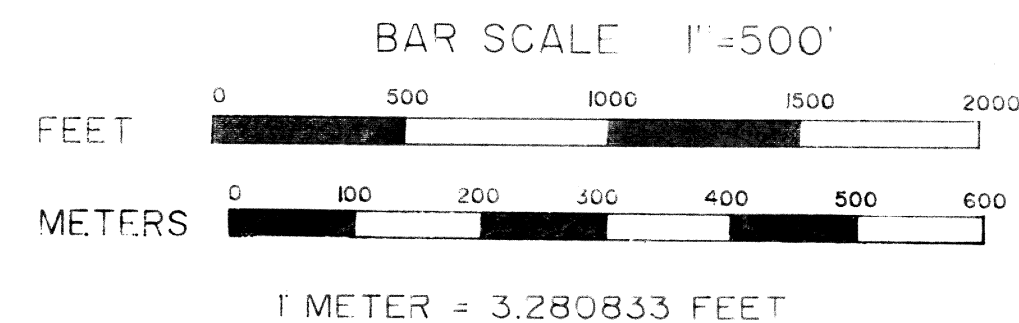

RECORD OF SURVEY

CURRAN CADASTRAL SURVEY

U.S.D.A. FOREST SERVICE - REGION 6
WALLOWA-WHITMAN NATIONAL FOREST
CONTRACT NO. 53-04M3-4-0064
SECTIONS 21, 22, 23, 26, 27, 28, 35 & 36 T1S, R37E, W.M.
BAKER COUNTY, OREGON

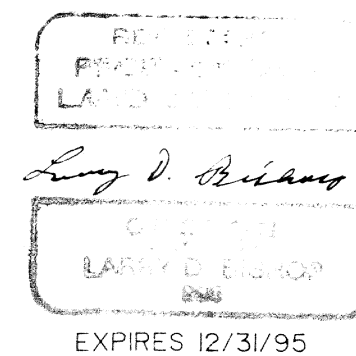

SHEET 2 OF 4

BISHOP SURVEYING, INC.
87830 TERRACE VIEW DR.
FLORENCE, OR. 97439
(503) 997-1308
PROJECT NO. 95010