
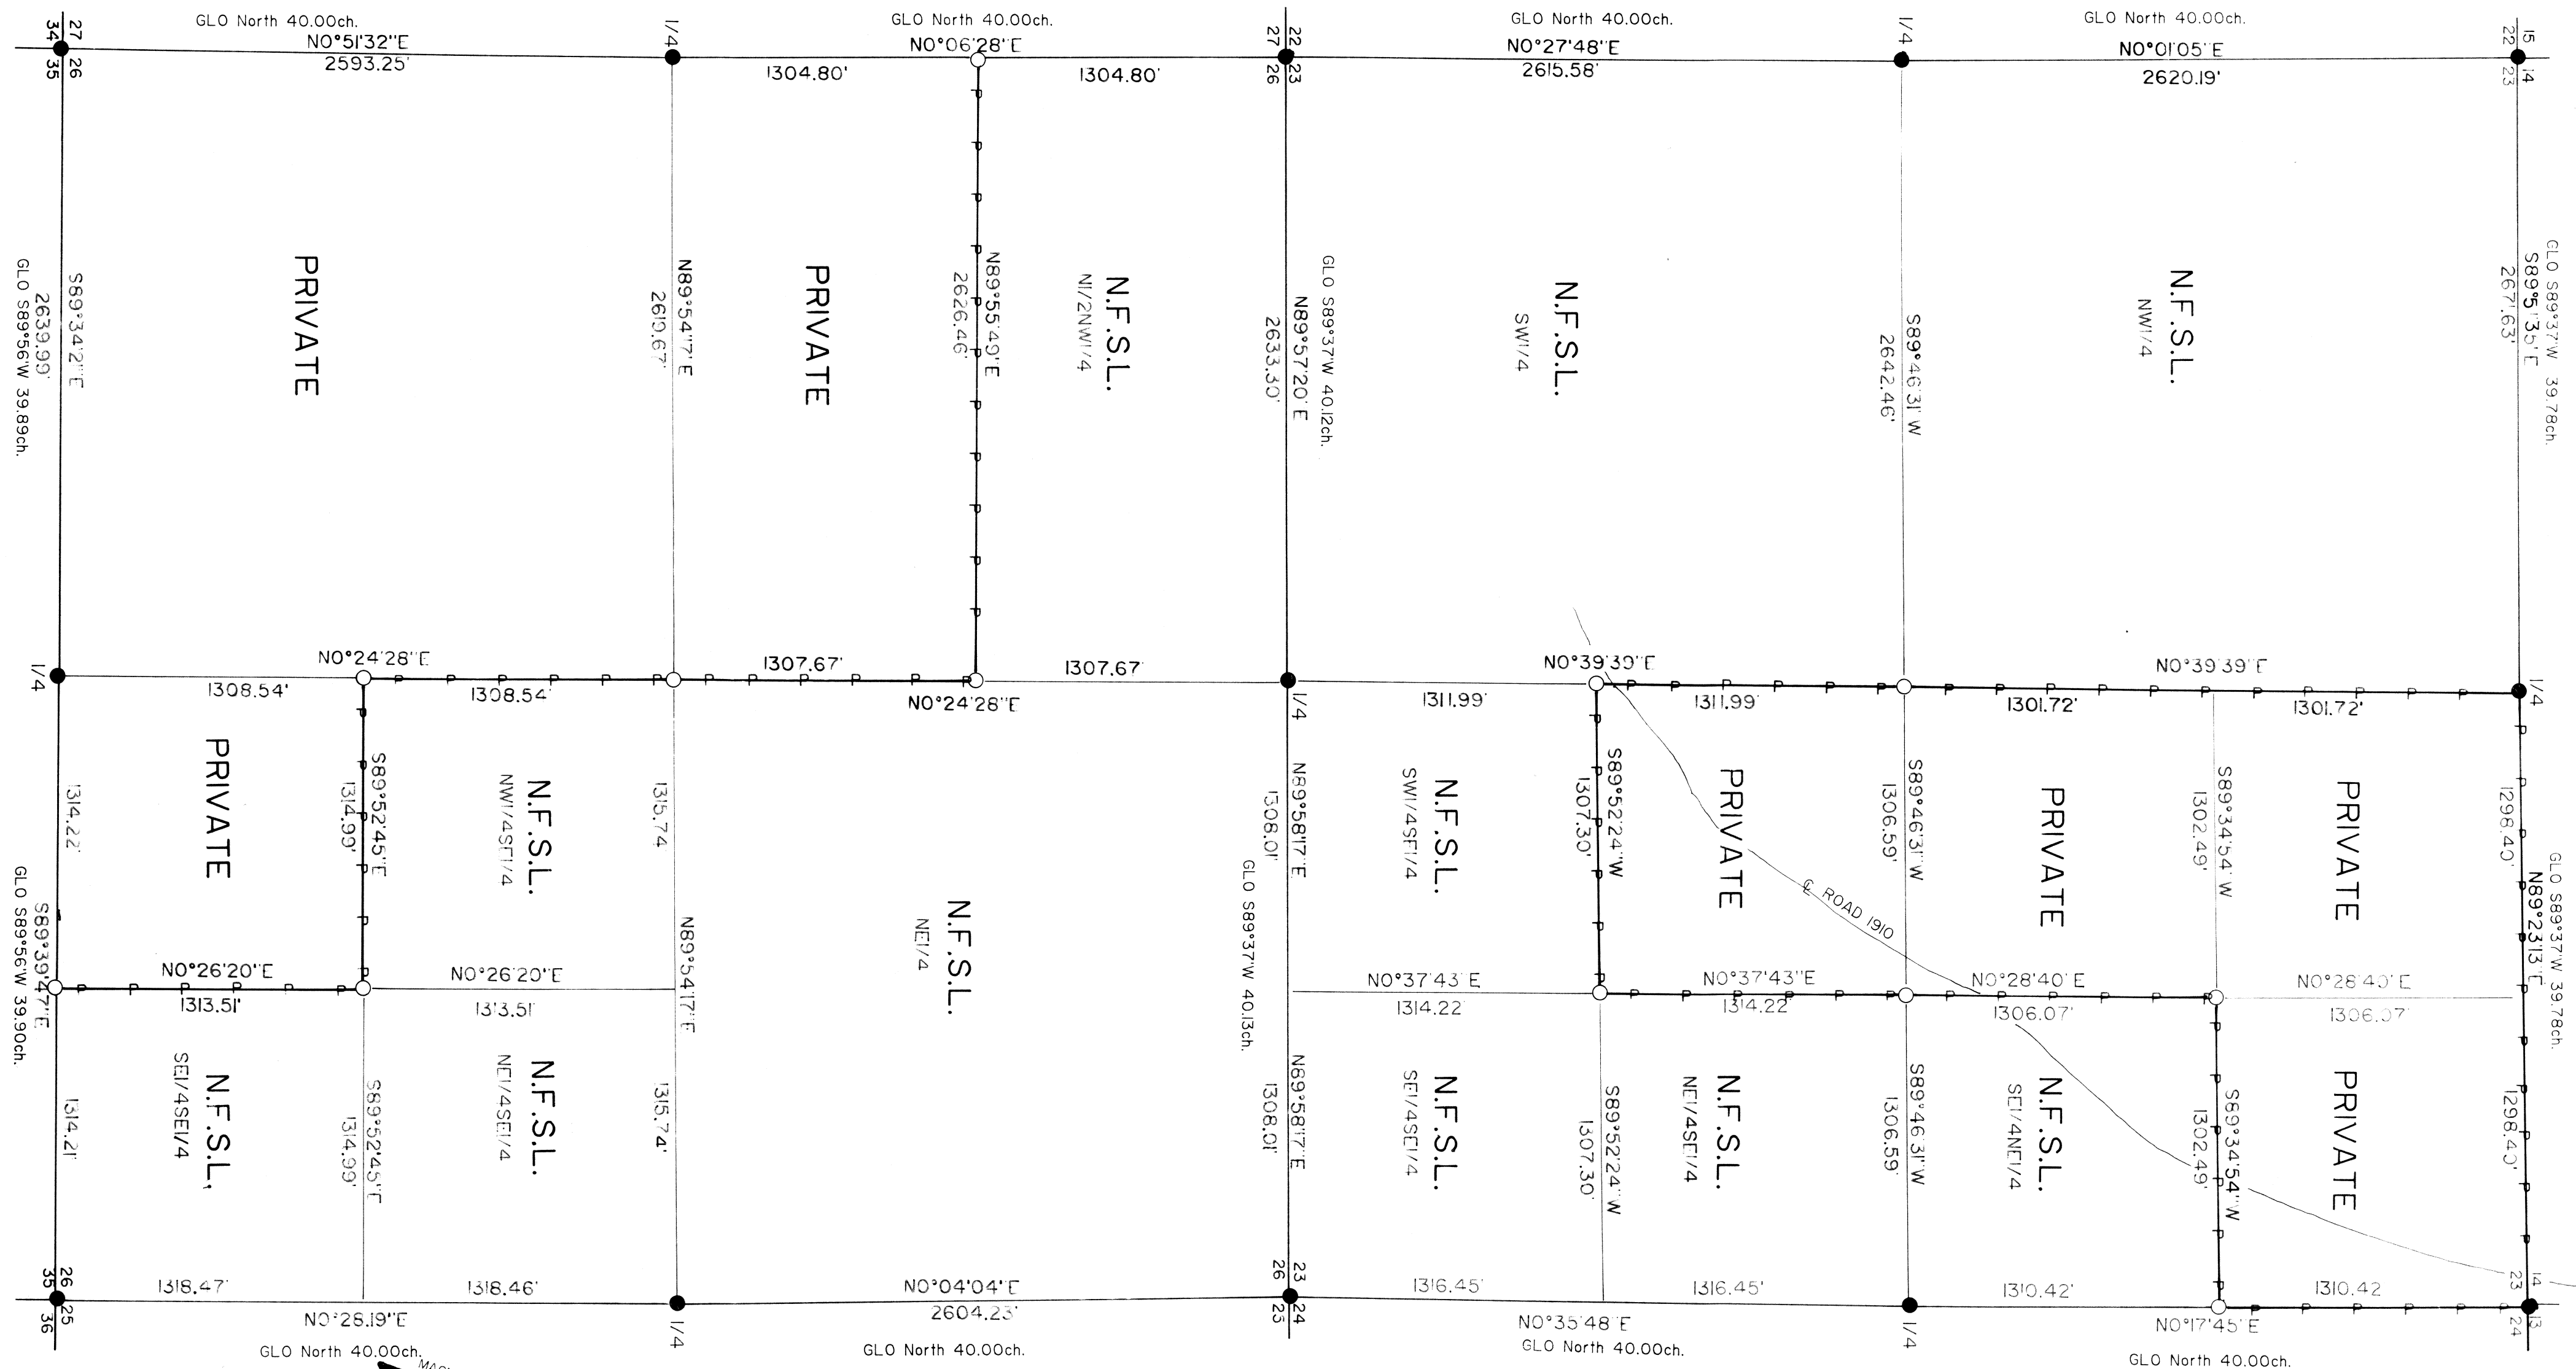


REGISTERED
PROFESSIONAL
LAND SURVEYOR
Larry D. Bishop
LARRY D. BISHOP
1965
EXPIRES 12/31/95

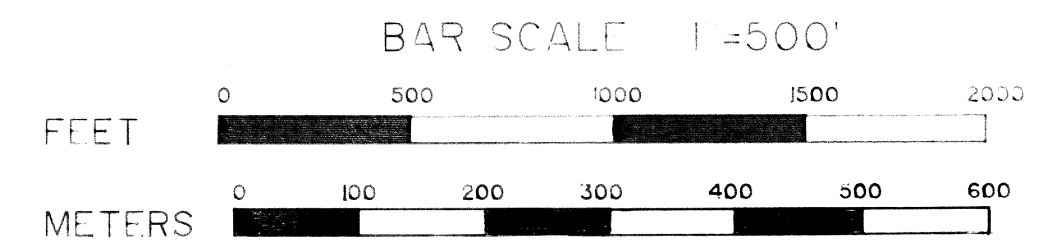

FEB. 4, 1998
11-37-75

RECORD OF SURVEY
CURRAN CADASTRAL SURVEY
U.S.D.A. FOREST SERVICE - REGION 6
WALLOWA-WHITMAN NATIONAL FOREST
CONTRACT NO. 53 04M3-4-0064
SECTIONS 2, 22, 23, 26, 27, 28, 35 & 36 T1S, R37E, W.M.
BAKER COUNTY, OREGON

SHEET 3 OF 4

BISHOP SURVEYING, INC.
87830 TERRACE VIEW DR.
FLORENCE, OR. 97439
(503) 997-1308
PROJECT NO. 95010