

CERTIFIED RECORD OF LAND CORNER MONUMENTATION...

N-15

History of original corner establishment:

Corner was established by Deputy Herman D. Gradon in 1881, contract #416. Set: Sandstone 16'x8"x5", 11" in ground, 1/4 on North face. Marked: 10" Juniper N65E--45 lks.; 12" Juniper S85W--28 lks..

Corner was monumented by BLM in 1974 from original evidence. See record field notes.

DIAGRAM

T11S R37E
1/4 $\frac{S15}{S22}$

Description of corner evidence found:


BLM iron post with a 3" brass cap firmly set in a large mound of stone. Stamped:

T11S R37E
1/4 $\frac{S15}{S22}$
1974


Orig. 12" now 22" Juniper S85W--18.5' Full scribing visible.
BLM 8" now 10" Juniper N27W--54.8'(record 55.4') Scribing visible.
No evidence of orig. NE BT remains

Description of monument and accessories established to perpetuate the original location of this corner:

Chiseled BXO on top 1½'x1½'x1' high raised outcrop of solid bedrock N14W--7.0'.
Chiseled BXO on top 2½'x2'x1½' high boulder N48 3/4W--24.6'.
Nailed 54-9 and 54-3 signs to BT's, painted bands, blazes and chisel marks red.
Reset guard post from next to monument South with 54-2 and 54-4 signs.
Impossible to set guard post East--very steep solid bedrock.
Bearings are magnetic--Declination 20°.

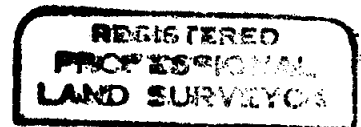

Larry D. Bigh...

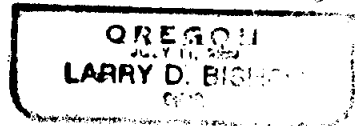

Expires 12/31/95

Office of..... County of.....
State of....., I hereby certify that the within instrument was filed in this office
for record on the..... day of....., 19.....
..... by
(COUNTY OFFICIAL) (DEPUTY)