

CERTIFIED RECORD OF LAND CORNER MONUMENTATION

N-19

History of original corner establishment:

Corner was established by Deputy Herman D. Gradon in 1881, contract #416. Set: Basalt stone 17"x11"x7", 11" in ground, 1/4 on North face. Marked: 12" Pine N65E--10 lks.; 30" Pine S50E--15 lks..

Corner was monumented by BLM in 1974 from original evidence. See record field notes.

DIAGRAM

T11S R37E
1/4 $\frac{S14}{S23}$

Description of corner evidence found:

Orig. 12" now 20" Ponderosa Pine N61E--6.9' (record N65E--10 lks.) Scribing visible on open upper blaze.
Orig. 30" now 28" Ponderosa Pine stump S50E--9.9' No marks remain.
BLM 7" now 8" Ponderosa Pine N7 3/4E--14.8' (record N9E) Scribing visible on partially healed blaze.
BLM 11" now 13" Larch S46E--15.5' Healed blaze.


BLM iron post with a 3" brass cap firmly set 4" above ground. Stamped:

T11S R37E
1/4 $\frac{S14}{S23}$
1974

Description of monument and accessories established to perpetuate the original location of this corner:

Chiseled BXO on top 1'x2'x1' high exposed boulder N17 3/4W--47.9'.
Nailed 54-9 and 54-3 signs to BT's, painted bands, blazes and chisel marks red.
Set guard posts East and South with 54-2 signs, one with 54-9 sign.

Bearings are true by instrument tie.

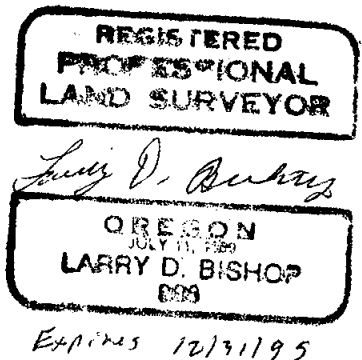

Office of..... County of.....
State of....., I hereby certify that the within instrument was filed in this office
for record on the..... day of....., 19....
..... by
(COUNTY OFFICIAL) (DEPUTY)