

CERTIFIED RECORD OF LAND CORNER MONUMENTATION

N-21

History of original corner establishment:

Corner was established by Deputy Herman D. Gradon in 1881, contract #416. Set: Sandstone 14"x7"x6", 9" in ground, three notches on South and one on East edge. Marked: 6" Larch N30E--53 lks.; 40" Pine S30E--23 lks. 30" Pine S25W--22 lks.; 18" Fir N70W--54 lks.

Corner was monumented by BLM in 1974 from original evidence. See record field notes.

DIAGRAM

--- T11S R37E
S14 | S13
S23 | S24

Description of corner evidence found:

BLM iron post with a 3" brass cap firmly set 4" above ground.
Stamped:


T11S R37E
S14 | S13
S23 | S24
1974

Orig. NE BT is gone.
Orig. SE BT now only a depression in ground.
Orig. 30" now 16" Ponderosa Pine stump S25W--15.5'(record 14.5') No marks remain.
Orig. 18" now down, rotted 22" D-Fir stood N70W--35.6' No marks remain.
BLM 11" now 11" Larch N43E--10.6' Healed blaze.
BLM 9" now 9" Larch S20E--7.9' Scribing visible on nearly healed blaze.
BLM 6" now down 7" Ponderosa Pine stood S67W--34.0' Scribing visible.
BLM 7" now 5" D-Fir N23W--19.5'(record 19.8') Healed blaze.


Description of monument and accessories | established to perpetuate the original location of this corner:

6" Ponderosa Pine S38 3/4W--36.2' Scribed T11S R37E S23 BT.
Nailed 54-9 and 54-3 signs to BT's, painted bands and blazes red and on new BT nailed a 1" brass disk stamped PLS 896 flush between the B and T.
Set guard posts South and West with 54-2 signs, one with 54-9 sign.

Bearings are true by instrument tie.

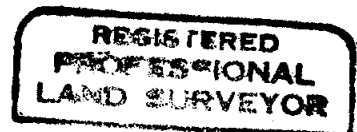

Larry D. Bishop

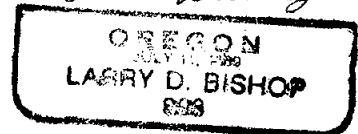

Exp 12/31/95

Office of..... County of.....
State of....., I hereby certify that the within instrument was filed in this office
for record on the..... day of....., 19.....
..... by
(COUNTY OFFICIAL) (DEPUTY)