

CERTIFIED RECORD OF LAND CORNER MONUMENTATION

O-20

History of original corner establishment:

N/A

DIAGRAM

T11S R37E
NE 1/16
S23

Description of corner evidence found:

N/A

Description of monument and accessories | established to perpetuate the original location of this corner:

Set 2½"x30" alum. pipe with a 2½" alum. cap 28" in ground.
Stamped:

T11S R37E
NE 1/16
S23
1995
LS 896

Marked:



11" Ponderosa Pine N6½E--62.4' Scribed XBT.

11" Ponderosa Pine N81E--52.3' Scribed NE 1/16 S23 BT.

Nailed 54-9 and 54-3 signs to BT's, painted bands and blazes red and nailed a 1" brass disk stamped PLS 896 flush between the B and T.

Set guard posts East and South with 54-2 signs, one with 54-9 sign.

Bearings are true by instrument tie.

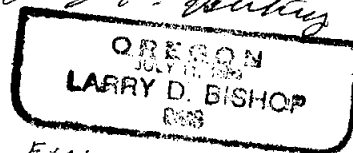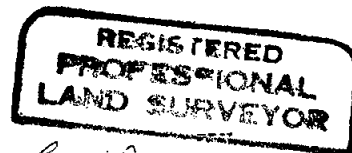

Office of..... County of.....
State of....., I hereby certify that the within instrument was filed in this office
for record on the..... day of....., 19.....

..... by
(COUNTY OFFICIAL) (DEPUTY)

Form R6-7100-57 (9/71)

FILED FEB. 4, 1998
BAKER COUNTY SURVEYOR
SURVEY NO. 11-37-83

*GPO-591-971, 1988