


History of original corner establishment:

Corner was established by Deputy Herman D. Gradon in 1881, contract #416. Set: Basalt stone 16"x10"x5", 11" in ground, 1/4 on West face. Marked: 36" Pine N55W--226 lks. ; Dug pit South of corner.

Corner was monumented by BLM in 1974 from original evidence. See record field notes.

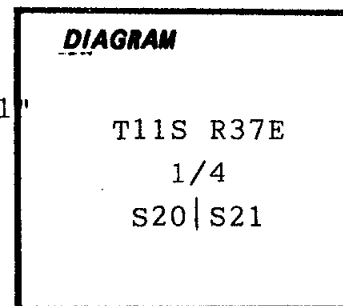

Description of corner evidence found:

BLM iron post with brass cap gone--destroyed by recent logging.
Orig. 36" NW BT destroyed by logging.
Unrecorded--probably orig. now 22" Ponderosa Pine N44E--16.5' Full scribing visible.
BLM 10" now 12" Ponderosa Pine S53E--7.8' Scribing visible on partially healed blaze.
BLM 12" now 14" Ponderosa Pine N49W--16.5'(record N47W) Scribing visible on partially healed blaze.

Description of monument and accessories | established to perpetuate the original location of this corner:


At intersection of record distances from BT's set 2½"x30" alum. pipe with a 2½" alum. cap 26" in ground. Buried remains of BLM monument next to monument set. Stamped:

T11S R37E
1/4
S20|S21
1995
LS 896

Marked:

Set a reference monument a 5/8"x30" iron rod with a 2" alum. cap S77 3/4W--24.1' Stamped: RM 1/4 S20, 1995, LS 896, N77 3/4E--24.1'.
Nailed 54-9 and 54-3 signs to BT's, painted bands and blazes red.
Set guard post South with 54-9 sign.

Bearings are true by instrument tie.

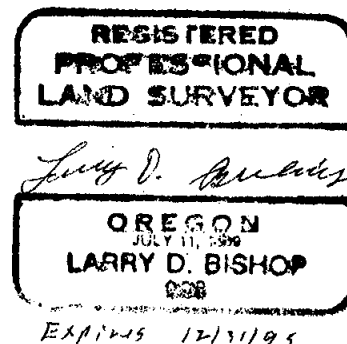

Office of..... County of.....
State of....., I hereby certify that the within instrument was filed in this office
for record on the..... day of....., 19.....
..... by
(COUNTY OFFICIAL) (DEPUTY)