


CERTIFIED RECORD OF LAND CORNER MONUMENTATION...

P-20

History of original corner establishment:

N/A

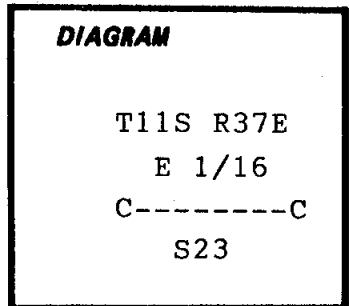

Description of corner evidence found:

N/A

Description of monument and accessories established to perpetuate the original location of this corner:

Set 2½"x30" alum. pipe with a 3" alum. cap 16" in ground in a mound of stone and earth 3' base to top. Stamped:

T11S R37E
E 1/16
C-----C
S23
1995
LS 896

Marked:



17" Ponderosa Pine N42¼E--46.7' Scribed CE 1/16 S23 BT.

18" Ponderosa Pine S43E--29.6' Scribed XBT.

Nailed 54-9 and 54-3 signs to BT's, painted bands and blazes red and nailed a 1" brass disk stamped PLS 896 flush between the B and T.

Set guard posts North and South with 54-2 signs, one with 54-9 sign.

Bearings are true by instrument tie.

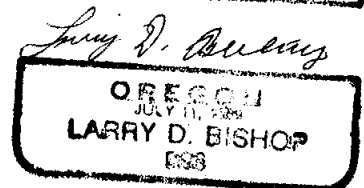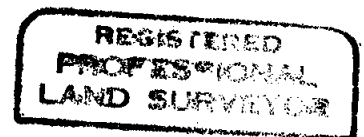

Expires 12/31/95

Office of..... County of.....

State of....., I hereby certify that the within instrument was filed in this office for record on the..... day of....., 19.....

..... by
(COUNTY OFFICIAL) (DEPUTY)

Form R6-7100-57 (9/71)

FILED FEB. 4, 1998
BAKER COUNTY SURVEYOR
SURVEY NO. 11-37-91

*GPO-591-971, 1988