


CERTIFIED RECORD OF LAND CORNER MONUMENTATION

Q-13

History of original corner establishment:

N/A

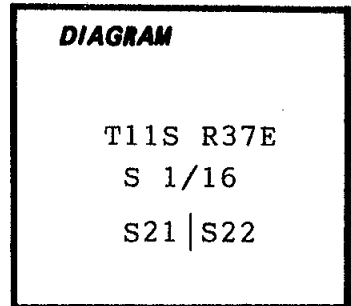

Description of corner evidence found:

N/A

Description of monument and accessories | established to perpetuate the original location of this corner:

T11S R37E
S 1/16
S21 | S22
1995
LS 896

Set: 2½"x30" alum. pipe with a 2½" alum. cap 24" in ground. Stamped:

Marked:


7" Ponderosa Pine N23 3/4W--20.1' Scribed S 1/16 S21 BT. ---

8" Ponderosa Pine S40E--33.9' Scribed S 1/16 S22 BT.


Nailed 54-9 and 54-3 signs to BT's, painted bands and blazes red and nailed a 1" brass disk stamped PLS 896 flush between the B and T.

Set guard posts East and West with 54-2 signs, one with 54-9 sign.

Bearings are true by instrument tie.

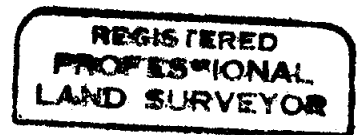

Larry D. Bishop

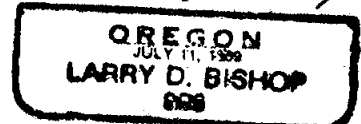

Expires 12/31/95

Office of..... County of.....

State of....., I hereby certify that the within instrument was filed in this office

for record on the..... day of....., 19.....

..... by
(COUNTY OFFICIAL) (DEPUTY)