

CERTIFIED RECORD OF LAND CORNER MONUMENTATION

R-11

History of original corner establishment:

Corner was established by Deputy Herman D. Gradon in 1881, contract #416. Set: Flint stone 16"x8"x5", 11" in ground, 1/4 on North face. Marked: 12" Quaking Aspen--North--8 lks.; 3" Quaking Aspen S60E--20 lks.

DIAGRAM

T11S R37E

1/4 $\frac{S21}{S28}$

Description of corner evidence found:

Searched for--not found.

Description of monument and accessories | established to perpetuate the original location of this corner: At proportion--


Set: 2½"x30" alum. pipe with a 2½" alum. cap 26" in rock slide, at the base of a 20" Ponderosa Pine. Mounded rock to top.
Stamped:

T11S R37E
1/4 $\frac{S21}{S28}$
1995
LS 896

Marked:

11" Ponderosa Pine N28½W--22.9' Scribed 1/4 S21 BT.
18" Ponderosa Pine S48 3/4W--15.5' Scribed 1/4 S28 BT.
Set reference monuments, 5/8"x30" iron rods with 2" alum. caps:
(1) N45 3/4W--60.3' Stamped: RM 1/4 S21, 1995, LS 896, S45 3/4E--60.3'.
(2) S85W--36.9' Stamped: RM 1/4 S28, 1995, LS 896, N85E--36.9'.
Nailed 54-9 and 54-3 signs to BT's, painted bands and blazes red and nailed a 1" brass disk stamped PLS 896 flush between the B and T.
Set guard post South with 54-2 and 54-9 signs.

Bearings are true by instrument tie.

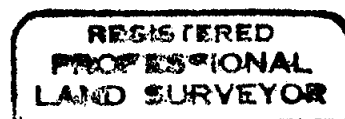

Larry D. Bishop
OREGON
JULY 11, 1994
LARRY D. BISHOP
P.S.
Expires 12/31/95

Office of..... County of.....
State of....., I hereby certify that the within instrument was filed in this office
for record on the..... day of....., 19.....
..... by
(COUNTY OFFICIAL) (DEPUTY)