


CERTIFIED RECORD OF LAND CORNER MONUMENTATION

R-17

History of original corner establishment:

Corner was established by Deputy Herman D. Gradon in 1881, contract #416. Set: Basalt stone 16"x10"x8", 11" in ground, two notches on South and East edges. Marked: 18" Larch N40E--77 lks.; 24" Larch S20E--61 lks.; 20" Fir S25W--14 lks.; 8" Larch N35W--105 lks.

Corner was monumented by BLM in 1974 from original evidence. See record field notes.

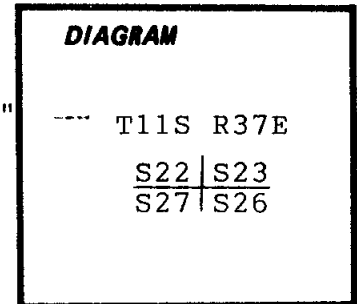

Description of corner evidence found:

BLM iron post with a 3" brass cap firmly set 6" above ground in a small mound of supporting stone on lower side. Stamped:

T11S R37E
S22|S23
S27|S26
1974

Orig. 18" now 32" Larch N40E--50.8' Scribing visible on partially healed blaze.
Orig. 24" now 30" Larch S20E--37.9'(record 40.3') No marks on opened blaze.
Orig. 8" now 16" Larch N35W--73.0'(record 105 lks.) Scribing visible on opened blaze.

No evidence of the orig. SW BT remains.



BLM 6" now 8" D-Fir S74W--37.7'(record 38.3') Healed blaze.

BLM 10" now 12" D-Fir N52W--11.0'(record 10.6') Healed blaze.

Description of monument and accessories established to perpetuate the original location of this corner:

Nailed 54-9 and 54-3 signs to BT's, painted bands and blazes red. Set guard post West with 54-9 sign.

Bearings are magnetic-Declination 20°

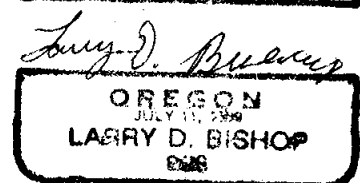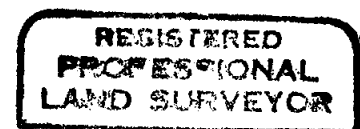

Expires 12/31/95

Office of..... County of.....

State of....., I hereby certify that the within instrument was filed in this office

for record on the..... day of....., 19.....

..... by
(COUNTY OFFICIAL) (DEPUTY)

FILED FEB. 4, 1998
BAKER COUNTY SURVEYOR
SURVEY NO. 11-37-102