

CERTIFIED RECORD OF LAND CORNER MONUMENTATION

R-21

History of original corner establishment:

Corner was established by Deputy Herman D. Gradon in 1881, contract #416. Set: Sandstone 16"x10"x10", 11" in ground with two notches on South and one on East. Marked: 30" Pine N60E--93 lks.; 14" Pine S20E--57 lks. 6" Fir S20W--140 lks.; 36" Pine N45W--68 lks.

Corner was monumented by BLM in 1974 from original evidence. See record field notes.

DIAGRAM

T11S R37E	
S23	S24
S26	S25

Description of corner evidence found:

BLM iron post with a 3" brass cap firmly set in a small mound of stone. Stamped:


T11S R37E	
S23	S24
S26	S25
1974	

Orig. 14" now 22" Ponderosa Pine S20E--37.6' Healed double blaze.
 Orig. 6" now 20" D-Fir S24½W--92.4'(record S24W) Healed double blaze.
 Orig. 36" now 20" Ponderosa Pine stump N44W--45.6'(record N45W--44.9') No marks remain.
 Orig. 30" now 30" Ponderosa Pine stump N59¼E--59.3'(record N60E--93 lks.) No marks remain.
 BLM 7" now 10" D-Fir N31W--68.3'(record N32W) Healed blaze.
 BLM 9" now 10" D-Fir N72½E--36.0'(record N67E--56 lks.) Healed blaze.

Description of monument and accessories | established to perpetuate the original location of this corner:

Nailed 54-9 and 54-3 signs to BT's, painted bands and blazes red. Set guard post SE with 54-4 sign.

Bearings are true by instrument tie.

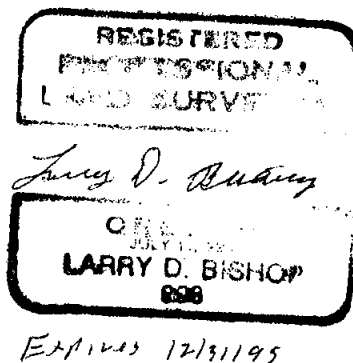

Office of..... County of.....
 State of....., I hereby certify that the within instrument was filed in this office
 for record on the..... day of....., 19.....
 by
 (COUNTY OFFICIAL) (DEPUTY)

FILED FEB. 4, 1998
 BAKER COUNTY SURVEYOR
 SURVEY NO. 11-37-104