


CERTIFIED RECORD OF LAND CORNER MONUMENTATION

S-12

History of original corner establishment:

N/A

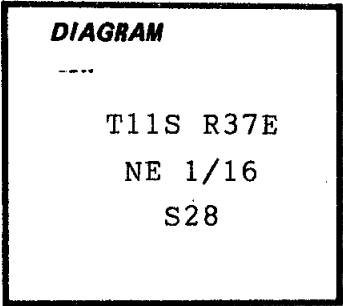

Description of corner evidence found:

N/A

Description of monument and accessories I established to perpetuate the original location of this corner:

T11S R37E
NE 1/16
S28
1995
LS 896


Set 2½"x30" alum. pipe with a 2½" alum. cap 16" in ground in a mound of stone and earth 4' base to top. Stamped:

Marked:

10" D-Fir N0¼E-- 32.9' Scribed NE 1/16 S28 BT.
11" D-Fir S67¼W--23.6' Scribed XBT.

Nailed 54-9 and 54-3 signs to BT's, painted bands and blazes red and nailed a 1" brass disk stamped PLS 896 flush between the B and T.
Set guard posts South and East with 54-2 signs, one with 54-9 sign.

Bearings are magnetic-Declination 20°

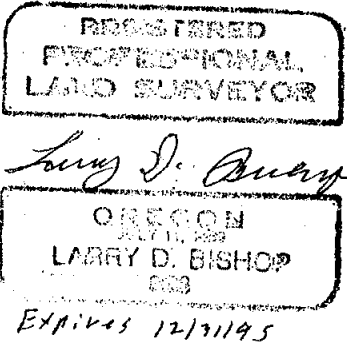

Office of..... County of.....
State of....., I hereby certify that the within instrument was filed in this office
for record on the..... day of....., 19.....
..... by
(COUNTY OFFICIAL) (DEPUTY)