


CERTIFIED RECORD OF LAND CORNER MONUMENTATION

S-19

History of original corner establishment:

N/A

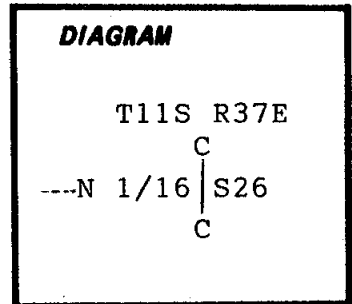

Description of corner evidence found:

N/A

Description of monument and accessories established to perpetuate the original location of this corner:

T11S R37E
C
N 1/16 | S26
C
1995
LS 896

Set: 2½"x30" alum. pipe with a 3" alum. cap 26" in ground.
Stamped:

Marked:

18" Ponderosa Pine N18W--18.7' Scribed CN 1/16 S26 BT.
8" D-Fir N77½E--26.2' Scribed CN 1/16 S26 BT.
Nailed 54-9 and 54-3 signs to BT's, painted bands and blazes red and nailed a 1" brass disk stamped PLS 896 flush between the B and T.
Set guard posts West and South with 54-2 signs, one with 54-9 sign.

Bearings are true by instrument tie.



Office of..... County of.....
State of....., I hereby certify that the within instrument was filed in this office
for record on the..... day of....., 19.....
..... by
(COUNTY OFFICIAL) (DEPUTY)

Form R6-7100-57 (9/71)

*GPO-591-971, 1988

FILED FEB. 4, 1998
BAKER COUNTY SURVEYOR
SURVEY NO. 11-37-109