

CERTIFIED RECORD OF LAND CORNER MONUMENTATION

T-9

History of original corner establishment:

Corner was established by Deputy Herman D. Gradon in 1881, contract #416. Set: Basalt stone 12"x10"x6", 8" in ground. Marked: 3" Quaking Aspen S48E--111ks.; 4" Alder West--331ks.

Corner was monumented by PLS 1639 in 1978.
See record corner monumentation forms.

DIAGRAM

T11S R37E
1/4
S29|S28

Description of corner evidence found:

2½" gal. iron pipe with a 2½" brass cap firmly set in a mound of stone 3' base to top. Stamped:


T11S R37E
1/4
S29|S28
1978
PLS 1639

1978 12" now 14" Ponderosa Pine S45W--10.8' Scribing visible on partially healed blaze.
1978 7" now 8" Ponderosa Pine N50E--11.5' Scribing visible on partially healed blaze.
Guard post East with 54-9 sign.


Description of monument and accessories | established to perpetuate the original location of this corner:

Chiseled BXO on NE face 3'x3'x3' boulder S21½W--44.6'.
Chiseled BXO on top 2'x1½'x6" high boulder S29½W--62.5'.
Nailed 54-9 and 54-3 signs to BT's, painted bands, blazes and chisel marks red.

Bearings are true by instrument tie.

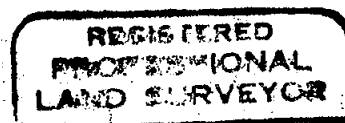

Larry D. Bishop

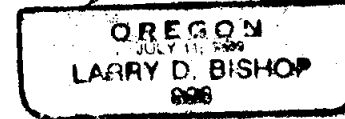

Expires 12/31/95

Office of..... County of.....
State of....., I hereby certify that the within instrument was filed in this office
for record on the..... day of....., 19.....
..... by
(COUNTY OFFICIAL) (DEPUTY)