


CERTIFIED RECORD OF LAND CORNER MONUMENTATION

T-12

History of original corner establishment:

N/A

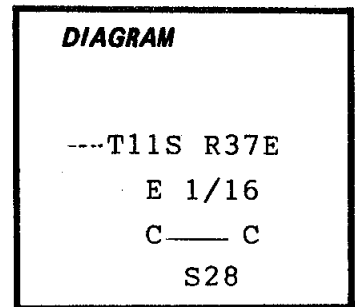

Description of corner evidence found:

N/A

Description of monument and accessories | established to perpetuate the original location of this corner:

Set 2½"x30" alum. pipe with a 2½" alum. cap 20" in ground to bedrock in a small mound of stone. Stamped:

T11S R37E
E 1/16
C——C
S28
1995
LS 896

Marked:



18" Juniper N40½W--26.9' Scribed CE 1/16 S28 BT.

22" Juniper N35E--33.4' Scribed CE 1/16 S28 BT.

Nailed 54-9 and 54-3 signs to BT's, painted bands and blazes red and nailed a 1" brass disk stamped PLS 896 flush between the B and T.

Set guard posts west and North with 54-2 signs, one with 54-9 sign.

Bearings are magnetic-Declination 20°

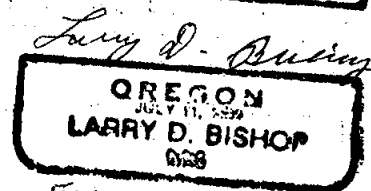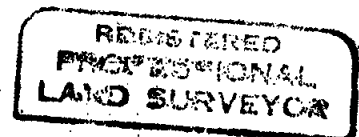

Expires 12/31/95

Office of..... County of.....

State of....., I hereby certify that the within instrument was filed in this office

for record on the..... day of....., 19.....

..... by
(COUNTY OFFICIAL) (DEPUTY)

FILED FEB. 4, 1998
BAKER COUNTY SURVEYOR
SURVEY NO. 11-37-112