


CERTIFIED RECORD OF LAND CORNER MONUMENTATION

T-13

History of original corner establishment:

Corner was established by Deputy Herman D. Gradon in 1881, contract #416. Set: Basalt stone 18"x6"x6", 12" in ground, 1/4 on West face. Dug pits 18"x18"x12" North and South, 5½' distance. Raised a mound of earth 1½' high 3' base alongside.

Corner was monumented by BLM in 1974 from original evidence. See record field notes.

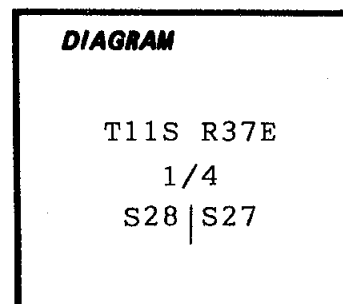

Description of corner evidence found:

BLM iron post with a 3" brass cap firmly set in a mound of stone 3' base 1½' high. Stamped:

T11S R37E
1/4
S28 | S27
1974

BLM 10" now 12" Juniper S78E--39.0' (record S77E--39.3') Scribing visible on nearly healed blaze.

BLM 7" now 9" Juniper N66W--10.9' (record N68W) Scribing visible on nearly healed blaze.

Description of monument and accessories I established to perpetuate the original location of this corner:

Chiseled BXO on top 3'x2'x1' exposed boulder S33½W--63.7'
Chiseled BXO on top 12"x6" flush exposed bedrock S38 3/4W--55.4'.
Nailed 54-9 and 54-3 signs to BT's, painted bands, blazes and chisel marks red.
Set guard post North with 54-9 sign.

Bearings are true by instrument tie.



Office of..... County of.....
State of....., I hereby certify that the within instrument was filed in this office
for record on the..... day of....., 19.....
..... by
(COUNTY OFFICIAL) (DEPUTY)