


CERTIFIED RECORD OF LAND CORNER MONUMENTATION

T-19

History of original corner establishment:

N/A

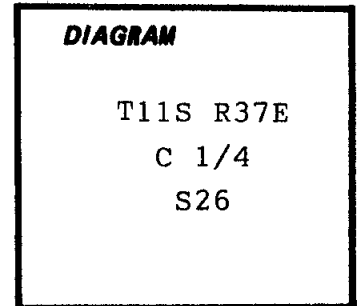

Description of corner evidence found:

N/A

Description of monument and accessories established to perpetuate the original location of this corner:

Set: 2½"x30" alum. pipe with a 2½" alum. cap 10" in ground in a mound of stone and earth 4½' base to top. Stamped:

T11S R37E
C 1/4
S26
1995
LS 896

Marked:

18" D-Fir N5 3/4W--15.3' Scribed C 1/4 S26 BT.

7" Juniper S76 3/4E--25.1' Scribed C 1/4 S26 BT.


Chiseled BX0 on top 2'x2'x1' high rock outcrop N58¼E--51.9'.

Chiseled BX0 on top 1'x1½' flush bedrock S32½E--52.1'.


Nailed 54-9 and 54-3 signs to BT's, painted bands, blazes and chisel marks red and nailed a 1" brass disk stamped PLS 896 flush between the B and T.

Set guard posts North and South with 54-2 signs, one with 54-9 sign.

Bearings are true by instrument tie.

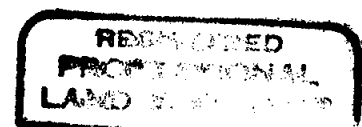

Larry D. Bishop

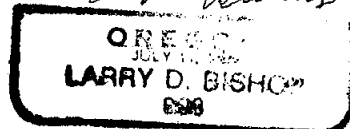

Expires 12/31/95

Office of..... County of.....

State of....., I hereby certify that the within instrument was filed in this office

for record on the..... day of....., 19.....

..... by

(COUNTY OFFICIAL)

(DEPUTY)

Form R6-7100-57 (9/71)

*GPO-591-971, 1988

FILED FEB 4, 1998

BAKER COUNTY SURVEYOR

SURVEY NO. 11-37-116