


CERTIFIED RECORD OF LAND CORNER MONUMENTATION

T-21

History of original corner establishment:

Corner was established by Deputy Herman D. Gradon in 1881, contract #416. Set: Basalt stone 16"x12"x7", 11" in ground, 1/4 on West face. Marked: 10" Juniper S75E 170 lks.; 10" Fir N80W--97 lks.

Corner was monumented by BLM in 1974 from original evidence. See record field notes.

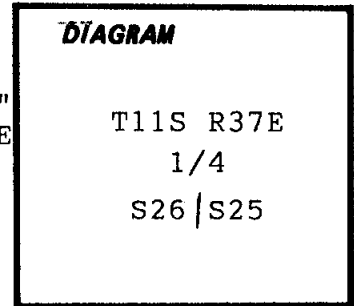

Description of corner evidence found:

Orig. 10" now 18" Juniper S75E--113.4' (record 170 lks.) Healed double blaze.
Orig. 10" now 18" D-Fir snag N80W--62.3' (record 98 lks.) Healed double blaze.
BLM 11" now 13" D-Fir N58W--27.3' (record 27.7') Healed blaze.

BLM iron post with a 3" brass cap firmly set in a mound of stone 4' base to top. Stamped:

T11S R37E
1/4
S26 | S25
1974

Description of monument and accessories established to perpetuate the original location of this corner:

Chiseled BXO on top 1'x3'x6" high rock outcrop N73W--27.9'.
Chiseled BXO on top 1'x1'x1' high rock outcrop N42E--10.1'.
Nailed 54-9 and 54-3 signs to BT's, painted bands, blazes and chisel marks red.
Set guard post South with 54-9 sign.

Bearings are magnetic-Declination 20°.



Office of..... County of.....
State of....., I hereby certify that the within instrument was filed in this office
for record on the..... day of....., 19.....
..... by
(COUNTY OFFICIAL) (DEPUTY)