


CERTIFIED RECORD OF LAND CORNER MONUMENTATION

U-20

History of original corner establishment:

N/A

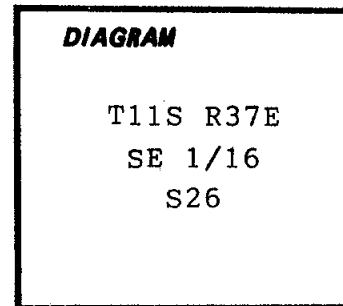

Description of corner evidence found:

N/A

Description of monument and accessories | established to perpetuate the original location of this corner:

T11S R37E
SE 1/16
S26
1995
LS 896

Set: 2½"x30" alum. pipe with a 3" alum. cap 14" in ground in a mound of stone and earth 3½' base to top. Stamped: _____

Marked:

10" Juniper N9W--38.5' Scribed SE 1/16 S26 BT.
19" Ponderosa Pine S62½E--63.6' Scribed SE 1/16 S26 BT.
Nailed 54-9 and 54-3 signs to BT's, painted bands and blazes red and nailed a 1" brass disk stamped PLS 896 flush between the B and T.
Set guard posts South and West with 54-2 signs, one with 54-9 sign.

Bearings are true by instrument tie.



Expires 12/31/95

Office of..... County of.....
State of....., I hereby certify that the within instrument was filed in this office
for record on the..... day of....., 19.....
..... by
(COUNTY OFFICIAL) (DEPUTY)