


CERTIFIED RECORD OF LAND CORNER MONUMENTATION

V-11

History of original corner establishment:

Corner was established by Deputy Herman D. Gradon in 1881, contract #416. Set: Basalt stone 15"x10"x10", 10" in ground, 1/4 on North face. Marked: 4" Quaking Aspen N5E--72 lks.; 16" Pine S84E--168 lks.

Corner was monumented by BLM in 1974 from original evidence. See record field notes.

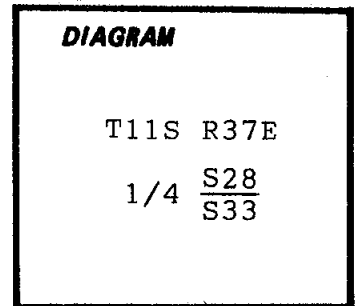

Description of corner evidence found:

BLM iron post with a 3" brass cap firmly set 4" above ground. Orig. stone alongside. Stamped:

T11S R37E
1/4 $\frac{S28}{S33}$
1974

Orig. SE BT destroyed by recent road construction. No evidence of the orig. NE BT remains.

BLM 8" now 9" Juniper S32E--41.6' Scribing visible on partially healed blaze. BLM NE BT destroyed by recent road construction.

Description of monument and accessories | established to perpetuate the original location of this corner:

14" Juniper N22½W--79.8' Scribed 1/4 S28 BT.
Chiseled BXO on top 3'x4'x1½' high rock outcrop N23½E--132.0'
Chiseled BXO on top 2'x3'x1' high rock outcrop S41½E--178.8'
Nailed 54-9 and 54-3 signs to BT's, painted bands, blazes and chisel marks red and on new BT nailed a 1" brass disk stamped PLS 896 flush between the B and T.
Set guard post South with 54-9 sign.

Bearings are magnetic-Declination 20°



Office of..... County of.....
State of....., I hereby certify that the within instrument was filed in this office
for record on the..... day of....., 19.....
..... by
(COUNTY OFFICIAL) (DEPUTY)

FILED FEB. 4, 1998
BAKER COUNTY SURVEYOR
SURVEY NO. 11-37-120