

CERTIFIED RECORD OF LAND CORNER MONUMENTATION

V- 13

History of original corner establishment:

Corner was established by Deputy Herman D. Gradon in 1881, contract #416. Set: Basalt stone 16"x10"x7", 11" in ground, one notch on the South and three on the East edges. Dug pits 10"x10"x12" in each section, 5½' distance and raised a mound of earth 2' high 4½' base alongside.

DIAGRAM

T11S R37E
S28 | S27
S33 | S34

Corner was monumented in 1983 by PLS 848 from original evidence. See record Land Corner Monumentation forms.

Description of corner evidence found:

2½" alum. pipe and cap firmly set in a mound of stone
3' base 1' high. Stamped:

T11S R37E
S28 | S27
S33 | S34
1983
PLS 896

1983 14" now 18" Ponderosa Pine N53E--63.9'(record N54E--83.2')
Healed blaze.

1983 16" now 18" Ponderosa Pine S54W--83.2'(record S53W--63.8') Scribing visible on partially healed blaze.


1983 11" now 13" Ponderosa Pine N57W--27.0' Scribing visible on partially healed blaze.

1983 6" now 6" Juniper S77E--50.0' Scribing visible.
Guard post North with 54-4 sign.


Description of monument and accessories | established to perpetuate the original location of this corner:

Nailed 54-9 and 54-3 signs to BT's, painted bands and blazes red.

Bearings are magnetic-Declination 20°.

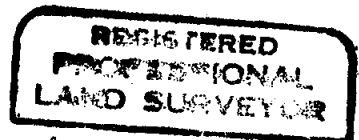

Larry D. Bishop

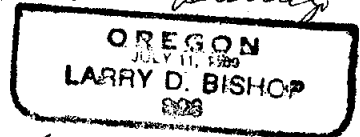

Expires 12/31/95

Office of..... County of.....
State of....., I hereby certify that the within instrument was filed in this office
for record on the..... day of....., 19.....

..... by
(COUNTY OFFICIAL) (DEPUTY)

Form R6-7100-57 (9/71)

FILED FEB. 4, 1998
BAKER COUNTY SURVEYOR
SURVEY NO. 11-37-121

*GPO-591-971, 1988