

CERTIFIED RECORD OF LAND CORNER MONUMENTATION

V-17

History of original corner establishment:

Corner was established by Deputy Herman D. Gradon in 1881, contract #416. Set: A sandstone 12"x12"x6" with 1 notch South and 2 East. Dug pits 18"x18"x12" in each section 5½' distance and raised mound of earth 2' high 4½' base.

Corner was monumented by BLM in 1974 from original evidence. See record field notes.

DIAGRAM

T11S R37E

S27	S26
S34	S35

Description of corner evidence found:

BLM iron post with a 3" brass cap firmly set 5" above ground. Stamped:

BLM 13" now 17" Juniper S26E--28.4' Scribing visible on partially healed blaze.

BLM 11" now 18" Juniper N22W--139.9' Scribing visible on nearly healed blaze.

BLM 14" now 18" Ponderosa Pine S6W--102.6'(record S7W--103.0') Healed blaze.

T11S R37E

S27	S26
S34	S35

1974

Description of monument and accessories established to perpetuate the original location of this corner:


Marked:

7" Juniper N47½E--59.7' Scribed T11S R37E S26 BT.


Nailed 54-9 and 54-3 signs to BT's, painted bands and blazes red and nailed a 1" brass disk stamped PLS 896 flush between the B and T.

Set guard post South with 54-9 sign.

Bearings are true by instrument tie.

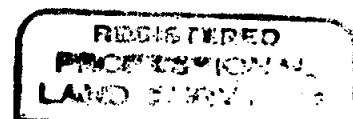

Larry D. Buehler

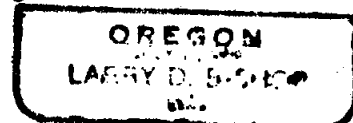

Expires 12/31/95

Office of..... County of.....

State of....., I hereby certify that the within instrument was filed in this office for record on the..... day of....., 19.....

..... by
(COUNTY OFFICIAL) (DEPUTY)

FILED FEB. 4, 1998
BAKER COUNTY SURVEYOR
SURVEY NO. 11-37-123