

CERTIFIED RECORD OF LAND CORNER MONUMENTATION

V-21

History of original corner establishment:

Corner was established by Deputy Herman D. Gradon in 1881, contract #416. Set: Basalt stone 17"x10"x7" 11" in ground, one notch each South and East. Marked: 15" Pine N25E--19 lks.: 30" Pine S50E--33 lks.: 16" Pine S35W--76 lks.: 6" Pine N25W--112 lks.

Corner was monumented by BLM in 1974 from original evidence. See record field notes.

DIAGRAM

T11S R37E	
S26	S25
S35	S36

Description of corner evidence found:



BLM iron post with a 3" brass cap firmly set 4" above ground. Stamped:
 Orig. 16" now 30" Ponderosa Pine S35W--50.2' Healed double blaze.
 Orig. 6" now 30" Ponderosa Pine N25W--74.2'(record 112 lks.) Healed double blaze.
 Orig. 15" now 22" Ponderosa Pine N25E--12.5' Scribing visible on partially healed blaze.
 Orig. 30" now uprooted 30" Ponderosa Pine, face to ground. Stood S50E--21.8'.
 BLM 13" now 15" D-Fir S8E--38.7'(record S9E--58 lks.) Healed blaze.
 BLM 6" now 8" Ponderosa Pine N52W--29.0' Healed blaze.

T11S R37E	
S26	S25
S35	S36
1974	

Description of monument and accessories | established to perpetuate the original location of this corner:

Nailed 54-9 and 54-3 signs to BT's as needed and painted bands and blazes red. Set guard post South with 54-9 sign.

Bearings are true by instrument tie.

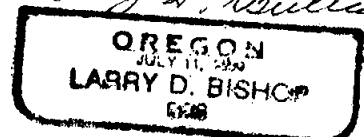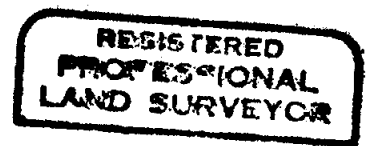

Expires 12/31/95

Office of..... County of.....
 State of....., I hereby certify that the within instrument was filed in this office
 for record on the..... day of....., 19.....

..... by
 (COUNTY OFFICIAL) (DEPUTY)

FILED FEB. 4, 1998
 BAKER COUNTY SURVEYOR
 SURVEY NO. 11-37-126