

CERTIFIED RECORD OF LAND CORNER MONUMENTATION

V-23

History of original corner establishment:

Corner was established by Deputy Herman D. Gradon in 1881, contract #416. Set: Basalt stone 16"x12"x8", 11 in ground, marked 1/4 on North. Marked: 4" Fir N60W--28 lks.; 24" Larch S40E--14 lks.

Corner was monumented by BLM in 1974 from original evidence. See record field notes.

DIAGRAM

T11S R37E

1/4 $\frac{S25}{S36}$

Description of corner evidence found:

BLM iron post with a 3" brass cap firmly set 6" above ground in a small mound of stone. Stamped:

T11S R37E



1/4 $\frac{S25}{S36}$
1974

Orig. 4" now down rotted 6" D-Fir N60W--18.5' No Marks remain.
Orig. SE BT now only slight depression in the ground.
BLM 10" now 12" D-Fir N82½E--26.3'(record N85E--41 lks.) Healed blaze.
BLM 8" now 9" Larch S31W--25.1'(record S35W) Healed blaze.

Description of monument and accessories | established to perpetuate the original location of this corner:

Chiseled BX0 on top 18"x12"x6" high boulder N75W--10.6'.
Chiseled BX0 on top 20"x7"x6" high rock outcrop S20½E--31.8'.
Nailed 54-9 and 54-3 signs to BT's, painted bands, blazes and chisel marks red.
Set guard post South with 54-9 sign.

Bearings are true by instrument tie.

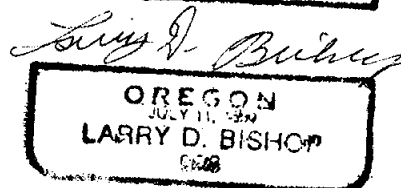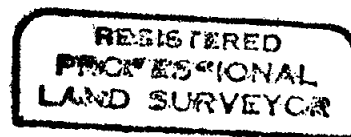

Exp. 12/31/93

Office of..... County of.....
State of....., I hereby certify that the within instrument was filed in this office
for record on the..... day of....., 19.....
..... by
(COUNTY OFFICIAL) (DEPUTY)