


CERTIFIED RECORD OF LAND CORNER MONUMENTATION

W-19

History of original corner establishment:

N/A

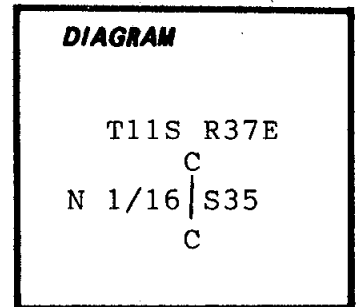

Description of corner evidence found:

N/A

Description of monument and accessories established to perpetuate the original location of this corner:

Set 2½"x30" alum. pipe with a 3" alum. cap 10" in ground in a mound of stone and earth 3½' base to top. Stamped:

T11S R37E
C
N 1/16 | S35
C
1995
LS 896

Marked:


14" Juniper N89½W--26.2' Scribed CN 1/16 S35 BT.

11" Juniper N7½E--57.5' Scribed CN 1/16 S35 BT.


Nailed 54-9 and 54-3 signs to BT's, painted bands and blazes red and nailed a 1" brass disk stamped PLS 896 flush between the B and T.

Set guard posts South and East with 54-2 signs, one with 54-9 sign.

Bearings are true by instrument tie.

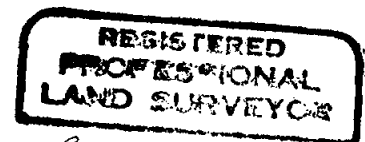

Larry D. Bishop

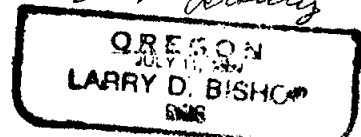

Expires 12/31/95

Office of..... County of.....
State of....., I hereby certify that the within instrument was filed in this office
for record on the..... day of....., 19....

..... by
(COUNTY OFFICIAL) (DEPUTY)