


CERTIFIED RECORD OF LAND CORNER MONUMENTATION---

W-20

History of original corner establishment:

N/A

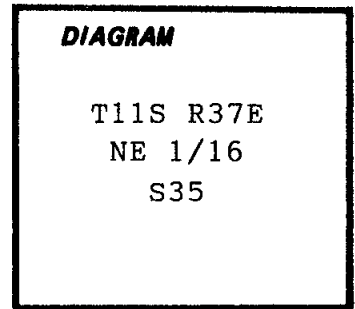

Description of corner evidence found:

N/A

Description of monument and accessories | established to perpetuate the  
original location of this corner:

Set: 2½"x30" alum. pipe with a 3" alum. cap 22" in ground.

Stamped:

Marked:

14" Ponderosa Pine S30W--17.3' Scribed NE 1/16 S35 BT.



9" Ponderosa Pine S86 3/4E--37.2' Scribed NE 1/16 S35 BT.

Nailed 54-9 and 54-3 signs to BT's, painted bands and blazes red and nailed a 1" brass disk stamped PLS 896 flush between the B and T.

Set guard posts West and North with 54-2 signs, one with 54-9 sign.

Bearings are true by instrument tie.

T11S R37E  
NE 1/16  
S35  
1995  
LS 896

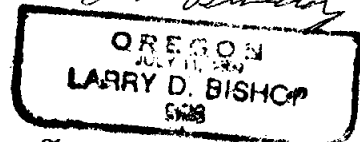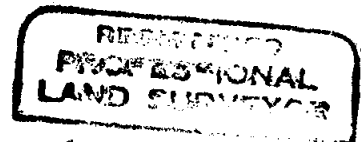

*Expires 12/31/95*

Office of..... County of.....

State of....., I hereby certify that the within instrument was filed in this office  
for record on the..... day of....., 19....

..... by .....  
(COUNTY OFFICIAL) (DEPUTY)