


CERTIFIED RECORD OF LAND CORNER MONUMENTATION

X-17

History of original corner establishment:

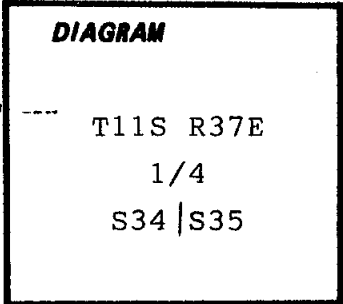

Corner was established by Deputy Herman D. Gradon in 1881, contract #416. Set: Basalt stone 16"x12"x5", 11" in ground with 1/4 on West. Marked: 14" Pine N84E--127 lks.; 36" Pine N60W--103 lks.

Corner was monumented by BLM in 1974 from original evidence. See record field notes.


Description of corner evidence found:

T11S R37E
1/4
S34 | S35
1974

BLM iron post with a 3" brass cap firmly set 5" above ground. Stamped:
Orig. 14" now 24" Ponderosa Pine stump with down stub alongside N86½E--84.7' (record N87E--127 lks.) Face to ground.
Orig. 36" now 36" Ponderosa Pine stump N55W--70.4' (record 103 lks.) No marks remain.
BLM 17" now 21" D-Fir S20W--25.9' (record 40 lks.) Healed blaze.
BLM 11" now 11" down Ponderosa Pine and out of position, stood N69E--16.8' Scribing visible.

Description of monument and accessories I established to perpetuate the original location of this corner:

8" Ponderosa Pine N25½E--20.2' Scribed 1/4 S35 BT.
Chiseled BXO on top 1'x1'x4" high exposed boulder N21½E--77.2'.
Set reference monument a 5/8"x30" iron rod with a 2" alum. cap N48½E--20.5'.
Stamped: RM 1/4 S35, 1995, LS 896, S48½W--20.5'.
Nailed 54-9 and 54-3 signs to BT's, painted bands, blazes and chisel marks red and on new BT nailed a 1" brass disk stamped PLS 896 flush between the B and T.
Set guard post South with 54-9 sign.
Bearings are true by instrument tie.

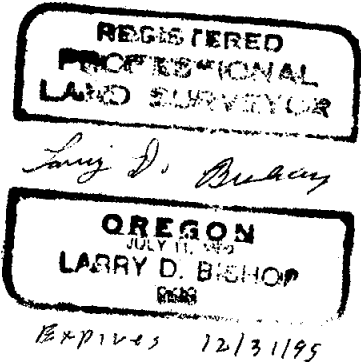

Office of..... County of.....
State of....., I hereby certify that the within instrument was filed in this office
for record on the..... day of....., 19.....
..... by
(COUNTY OFFICIAL) (DEPUTY)