

CERTIFIED RECORD OF LAND CORNER MONUMENTATION

X-18

History of original corner establishment:

N/A

**DIAGRAM**

T11S R37E  
W 1/16  
C-----C  
S35

Description of corner evidence found:

N/A

Description of monument and accessories established to perpetuate the original location of this corner:



Set: 2½"x30" alum. pipe with a 3" alum. cap 26" in ground.  
Stamped:

T11S R37E  
W 1/16  
C-----C  
S35  
1995  
LS 896

Marked:

9" Juniper N0½E--10.8' Scribed CW 1/16 S35 BT.  
15" Ponderosa Pine S29E--32.5' Scribed CW 1/16 S35 BT.  
Nailed 54-9 and 54-3 signs to BT's, painted bands and blazes red and nailed a 1" brass disk stamped PLS 896 flush between the B and T.  
Set guard posts South and East with 54-2 signs, one with 54-9 sign.

Bearings are true by instrument tie.

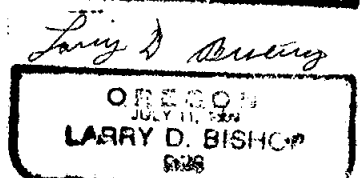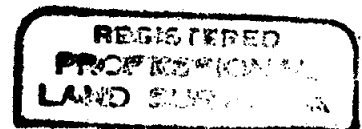

Expires 12/31/95

Office of..... County of.....  
State of....., I hereby certify that the within instrument was filed in this office  
for record on the..... day of....., 19.....

..... by .....  
(COUNTY OFFICIAL) (DEPUTY)

Form R6-7100-57 (9/71)

FILED FEB. 4, 1998  
BAKER COUNTY SURVEYOR  
SURVEY NO. 11-37-132

\*GPO-591-971, 1988