


CERTIFIED RECORD OF LAND CORNER MONUMENTATION

X-19

History of original corner establishment:

N/A

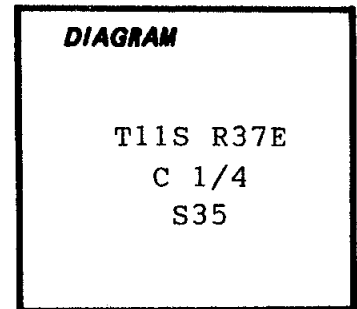

Description of corner evidence found:

N/A

Description of monument and accessories established to perpetuate the original location of this corner:

T11S R37E
C 1/4
S35
1995
LS 896

Set: 2½"x30" alum. pipe with a 3" alum. cap 30" in ground.

Stamped:

Marked:

10" Ponderosa Pine S81 3/4W--38.7' Scribed C 1/4 S35 BT.---

10" Ponderosa Pine N39½E--15.7' Scribed XBT.

Chiseled BXO on top 3'x3'x3' high boulder N79 3/4E--28.3'.



Set reference monument a 5/8"x30" iron rod with a 2" alum. cap S61 3/4E--19.9'

Stamped: RM C 1/4 S35 1995 LS 896 N61 3/4W--19.9'

Nailed 54-9 and 54-3 signs to BT's, painted bands, blazes and chisel marks red and nailed a 1" brass disk stamped PLS 896 flush between the B and T.

Set guard posts West and North with 54-2 signs, one with 54-9 sign.

Bearings are true by instrument tie.

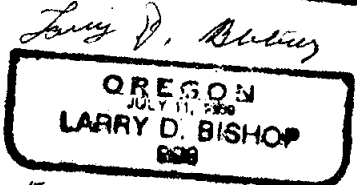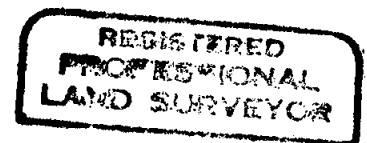

Expires 12/31/95

Office of..... County of.....

State of....., I hereby certify that the within instrument was filed in this office

for record on the..... day of....., 19....

..... by
(COUNTY OFFICIAL) (DEPUTY)

Form R6-7100-57 (9/71)

*GPO-591-971, 1988

FILED FEB. 4, 1998

BAKER COUNTY SURVEYOR

SURVEY NO. 11-37-133