

CERTIFIED RECORD OF LAND CORNER MONUMENTATION

X-21

History of original corner establishment:

Corner was established by Deputy Herman D. Gradon in 1881, contract #416. Set: Basalt stone 18"x10"x8", 12" in ground, 1/4 on West. Marked: 18" Pine S40E--55 lks. 30" Pine N75W--74 lks.

Corner was monumented by BLM in 1974 from original evidence. See record field notes.

DIAGRAM

T11S R37E
1/4
S35/S36

Description of corner evidence found:

BLM iron post with a 3" brass cap firmly set in a mound of stone 2' base 1½' high. Stamped:

Orig. 18" now 20" Ponderosa Pine S40E--36.3' Scribing visible on open double blaze.

Orig. NW BT is gone.

BLM 9" White Fir now 12" D-Fir N34E--10.5' (record 17½ lks.) Healed blaze.

BLM SW BT down and out of position.

T11S R37E
1/4
S35/S36
1974


Description of monument and accessories established to perpetuate the original location of this corner:

Chiseled BXO on SW face 3'x2'x2' high rock outcrop N58¼E--41.5'.


Chiseled BXO on top 2'x2' exposed bedrock N26½W--43.9'.

Nailed 54-9 and 54-3 signs to BT's, painted bands, blazes and chisel marks red. Set guard post North with 54-9 sign.

Bearings are true by instrument tie.

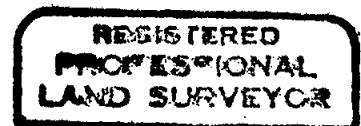

Larry D. Bishop

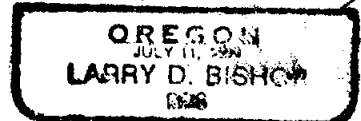

EXPIRES 12/31/95

Office of..... County of.....
State of....., I hereby certify that the within instrument was filed in this office
for record on the..... day of....., 19.....

..... by
(COUNTY OFFICIAL) (DEPUTY)