


CERTIFIED RECORD OF LAND CORNER MONUMENTATION

X-24

History of original corner establishment:

N/a

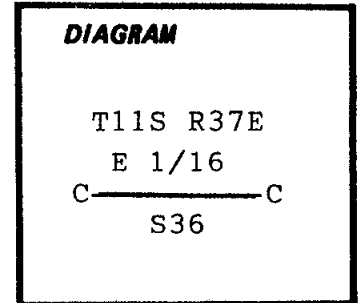

Description of corner evidence found:

N/A

Description of monument and accessories established to perpetuate the original location of this corner:



T11S R37E
E 1/16
C ————— C
S36
1995
LS 896

Set: 2½"x30" alum. pipe with a 3" alum. cap 16" in ground--
to bedrock in a mound of stone 3' base to top. Stamped:

Marked:

Chiseled BX0 on top flush bedrock 18"x4½' N3½W--40.1'.
6" Ponderosa Pine S55½W--17.6' Scribed CE 1/16 S36 BT.
Nailed 54-9 and 54-3 signs to BT, painted bands, blazes and chisel marks red
and nailed a 1" brass disk stamped PLS 896 flush between the B and T.
Set guard posts East and South with 54-2 signs, one with 54-9 sign.

Bearings are true by instrument tie.

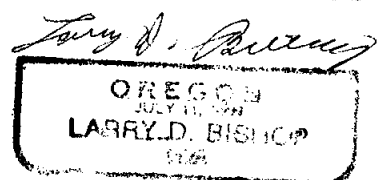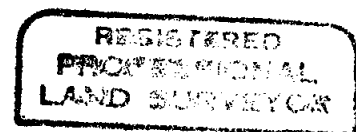

Expires 12/31/95

Office of..... County of.....
State of....., I hereby certify that the within instrument was filed in this office
for record on the..... day of....., 19.....
..... by
(COUNTY OFFICIAL) (DEPUTY)

FILED FEB. 4, 1998
BAKER COUNTY SURVEYOR
SURVEY NO. 11-37-136